



17.10.16

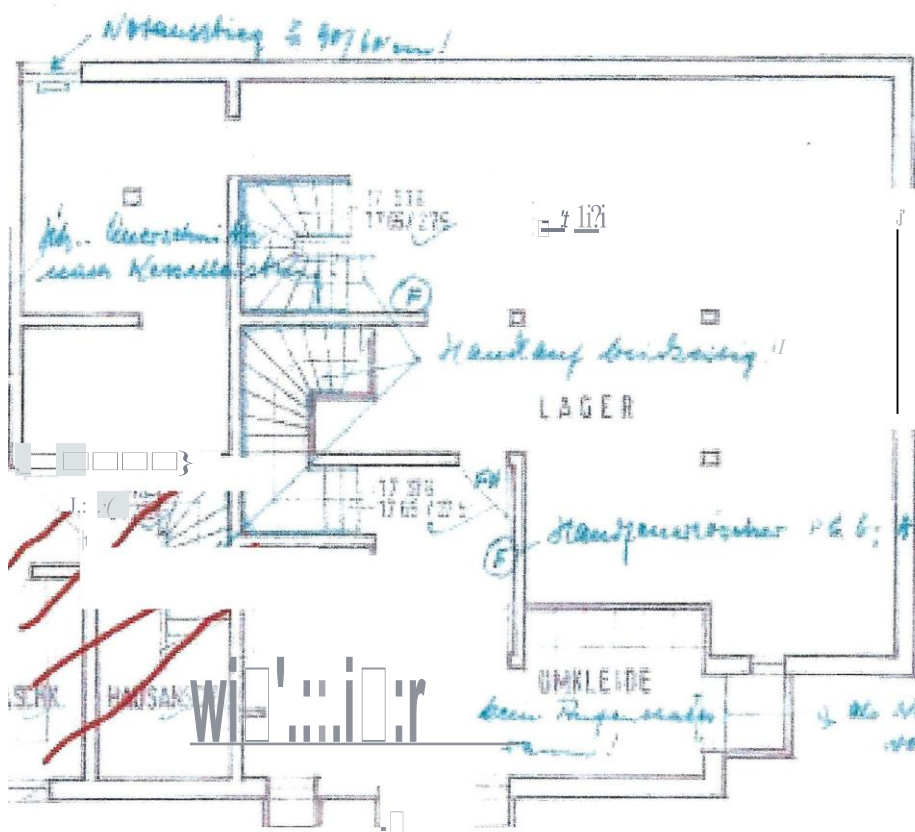

KELLE GESCHOSS


Handwritten signature or initials.

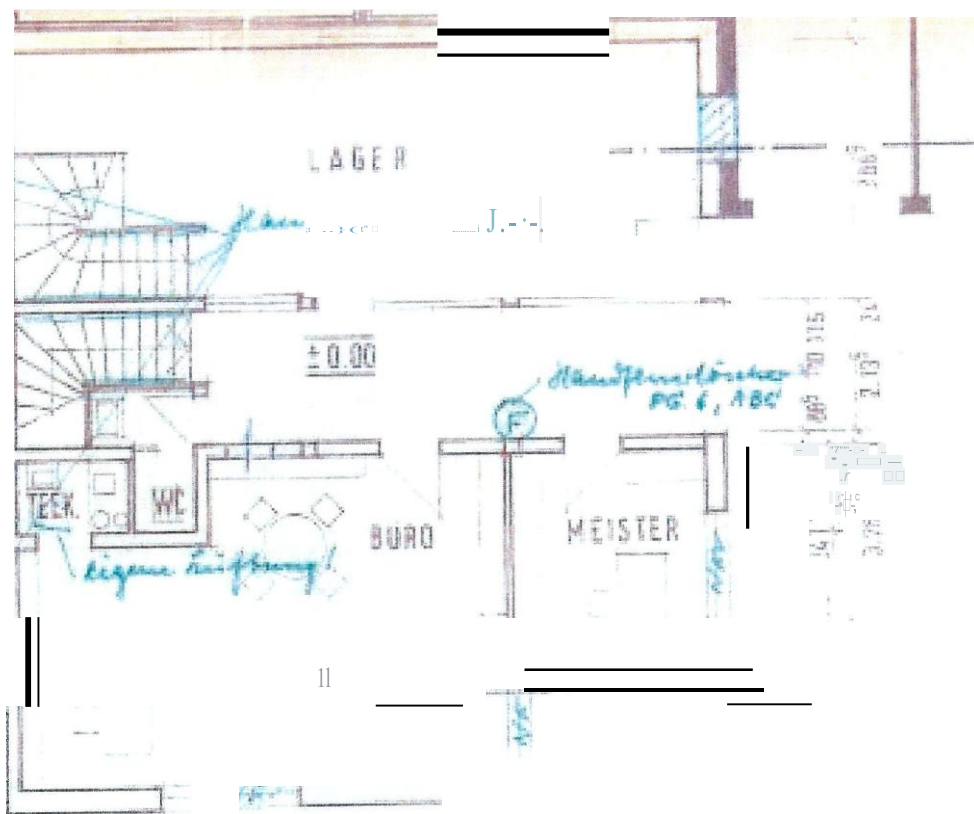

ERDGESCHOSS


11

17.10.16

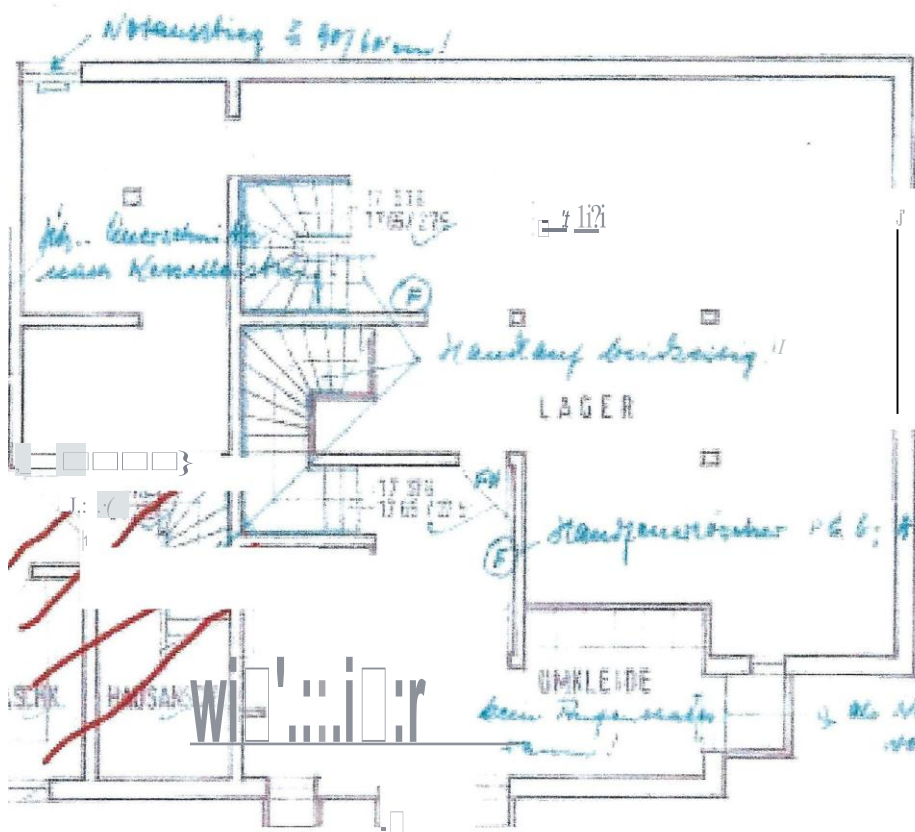

KELLE GESCHOSS

Handwritten signature or initials.

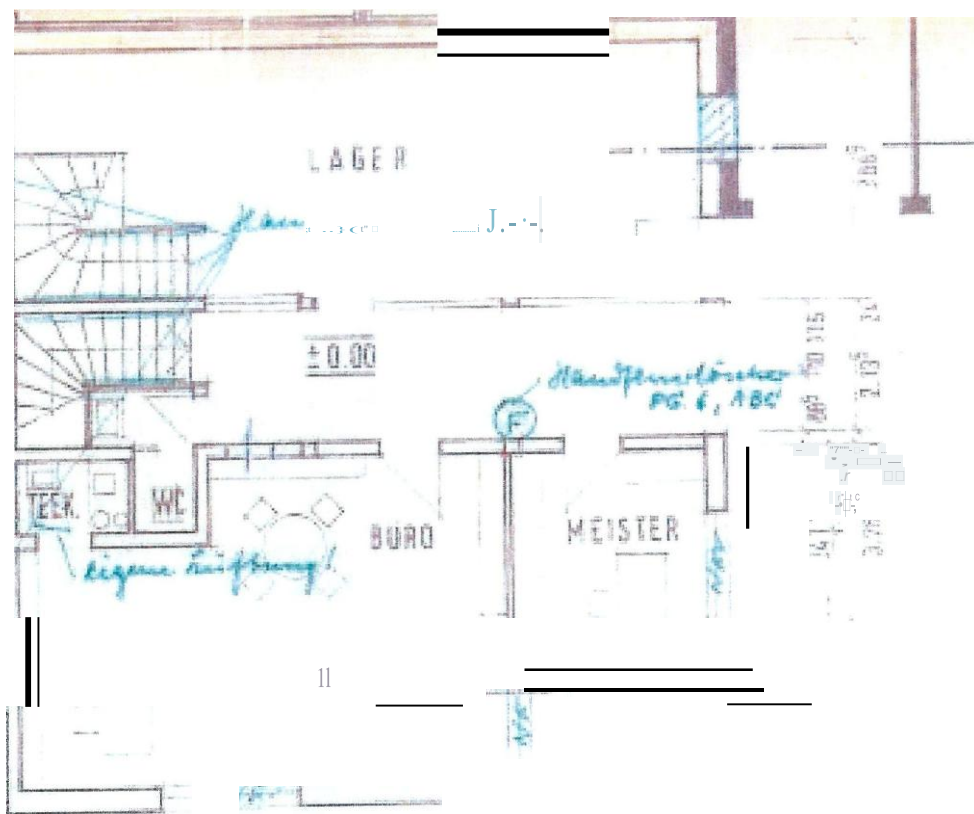

ERDGESCHOSS

11