



486

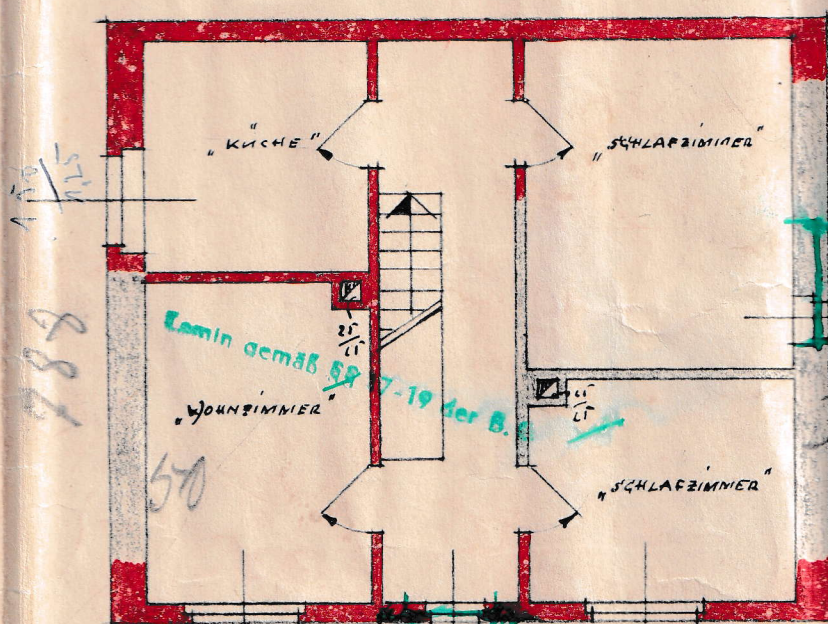

1.50
1.25

1.10
1.25

1.50
1.25

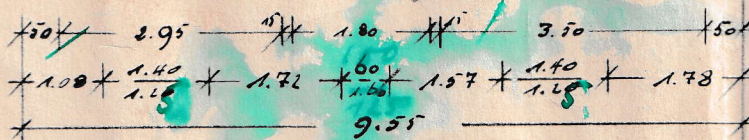

33 Anschlag 24
Hill = Hülle

OBERGESCHOSS

32

40