


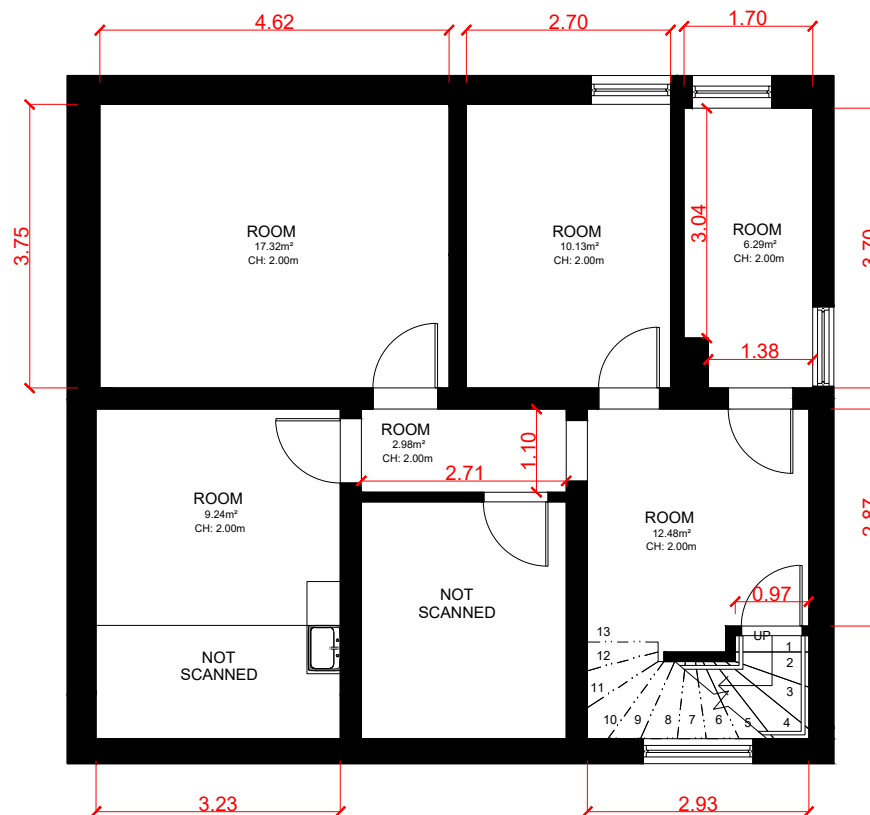

0_MERGE BRILONER GESAMT

1ST FLOOR

FLOOR AREA: 324 m²


BUILDING ELEMENTS: ARCH

DATE ISSUE: 28/06/26

PROJECT SCALE: 1/100

PAPER SIZE: A4

GRAPHIC SCALE: 0 1 2 m

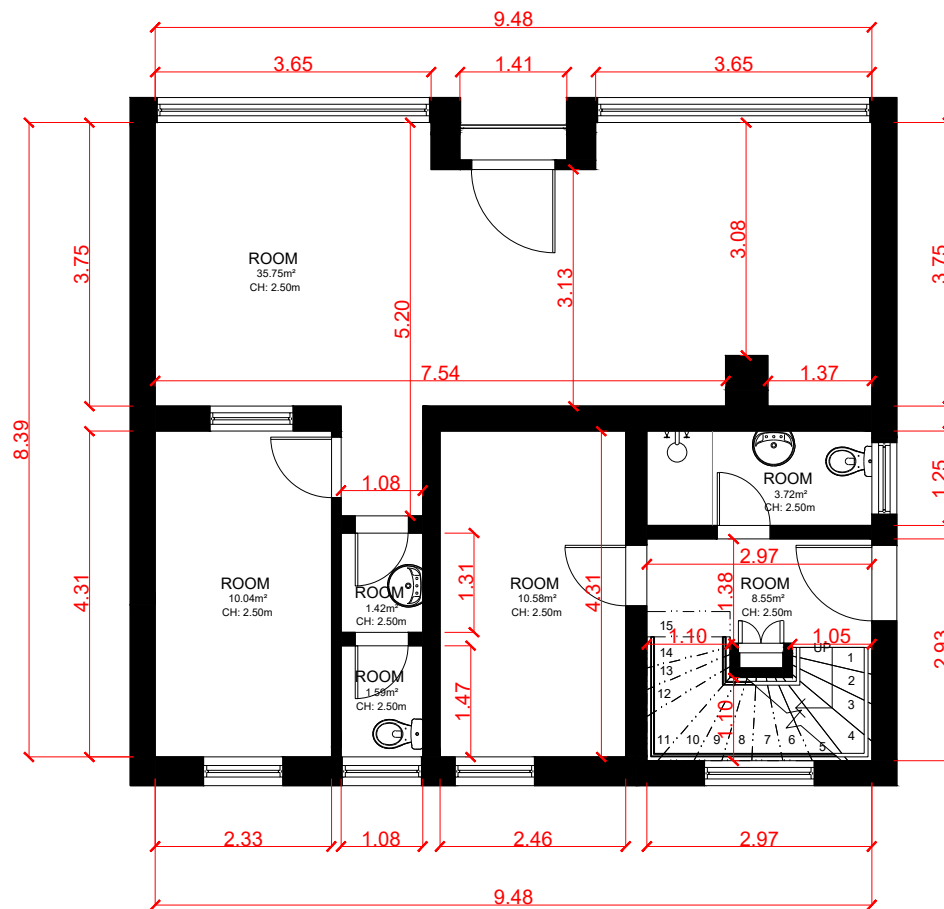

0_MERGE BRILONER GESAMT

2ND FLOOR

FLOOR AREA: 324 m²


BUILDING ELEMENTS: ARCH

DATE ISSUE: 28/06/26

PROJECT SCALE: 1/100

PAPER SIZE: A4


GRAPHIC SCALE: 0 1 2 m

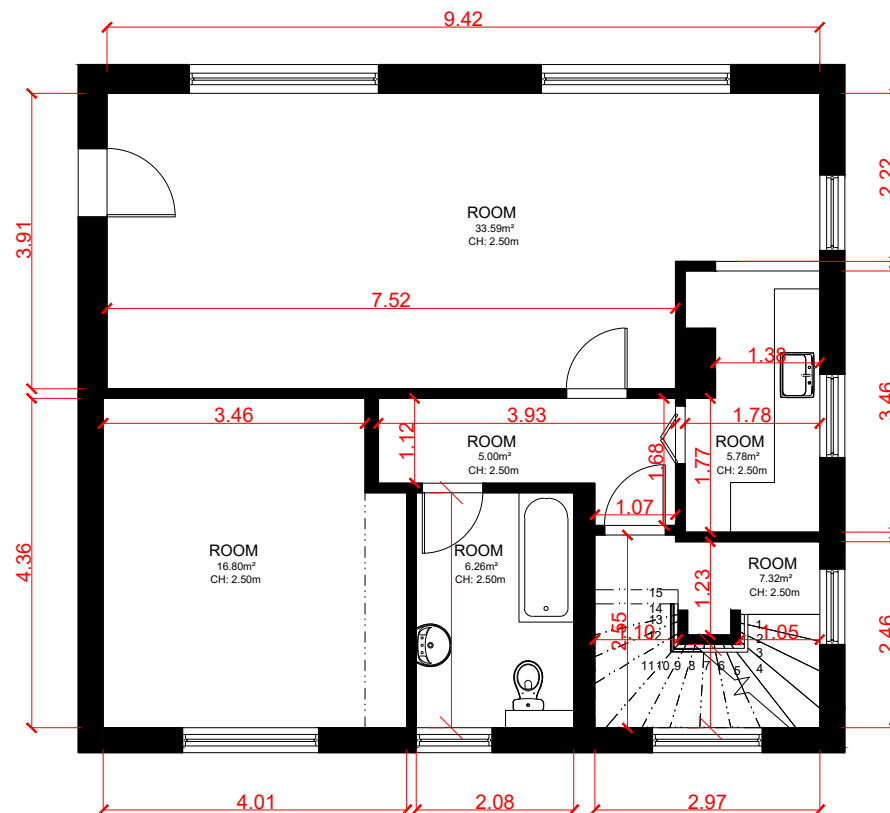

0_MERGE BRILONER GESAMT

3RD FLOOR

FLOOR AREA:	324 m ²
BUILDING ELEMENTS:	ARCH
DATE ISSUE:	28/06/26
PROJECT SCALE:	1/100
PAPER SIZE:	A4
GRAPHIC SCALE:	

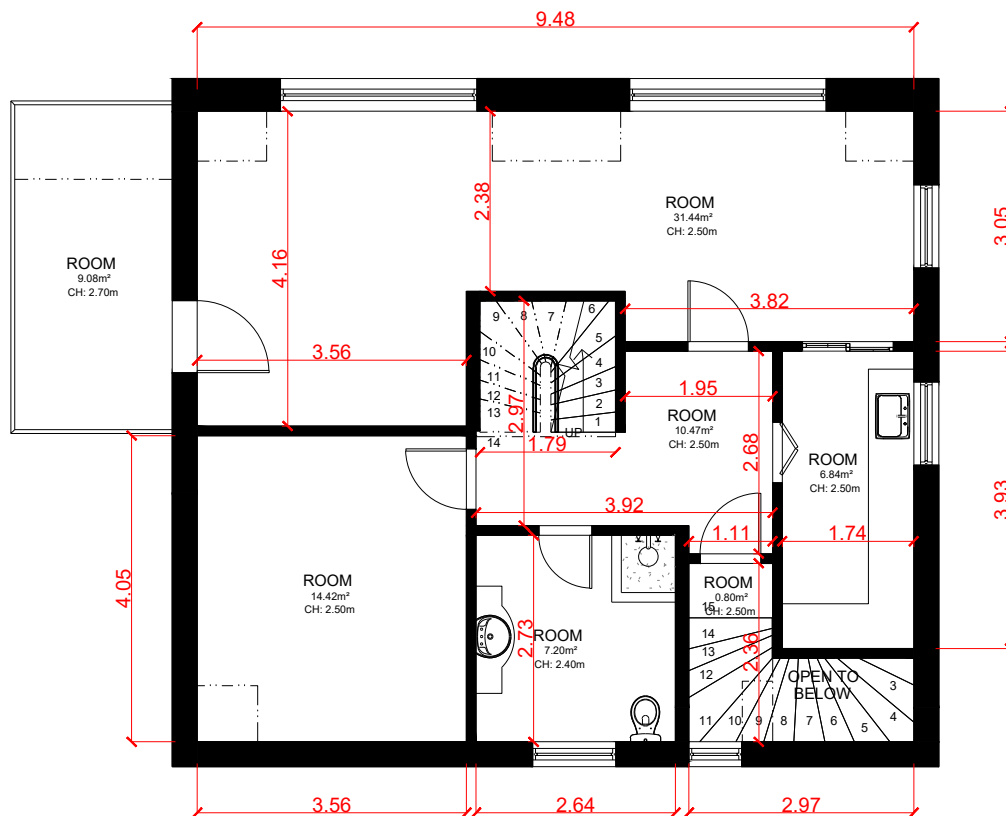

0_MERGE BRILONER GESAMT

4TH FLOOR

FLOOR AREA: 324 m²


BUILDING ELEMENTS: ARCH

DATE ISSUE: 28/06/26

PROJECT SCALE: 1/100

PAPER SIZE: A4

GRAPHIC SCALE: 0 1 2 m

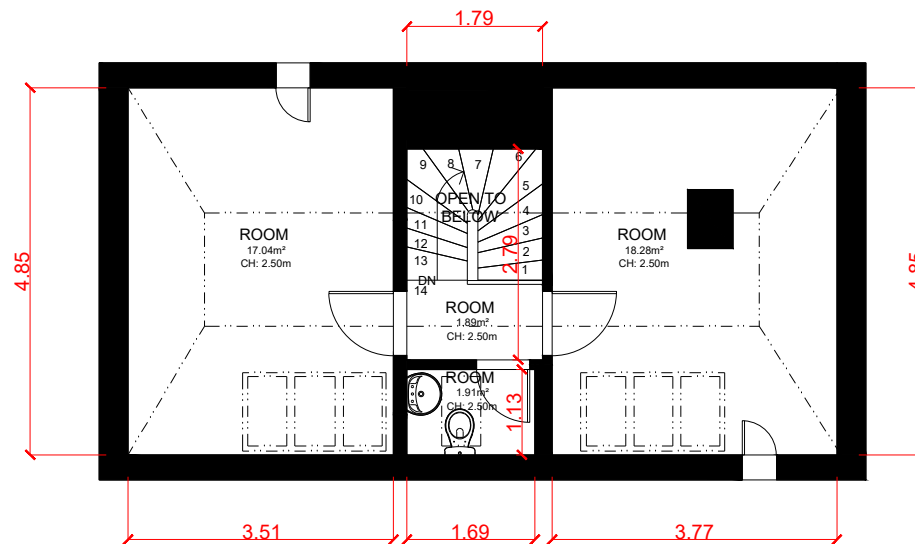

0_MERGE BRILONER GESAMT

5TH FLOOR

FLOOR AREA: 324 m²

BUILDING ELEMENTS: ARCH

DATE ISSUE: 28/06/26

PROJECT SCALE: 1/100

PAPER SIZE: A4

GRAPHIC SCALE: 0 1 2 m