


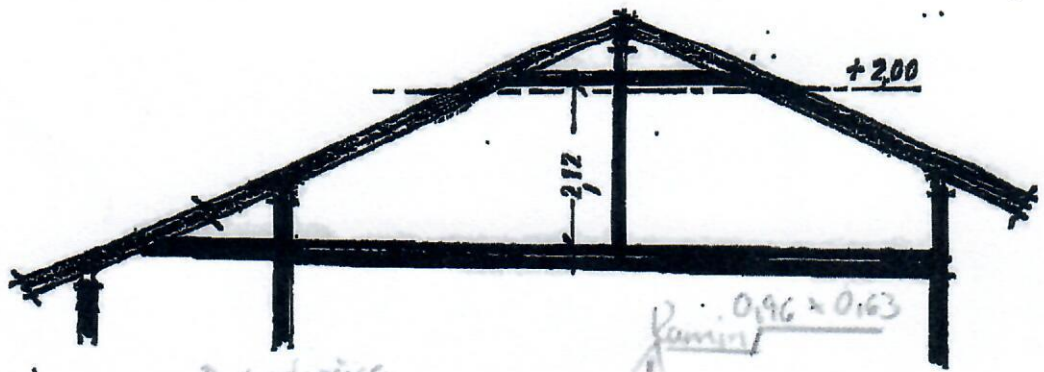

Dachschräge 2.84

Kamin 0.96 x 0.63


2.45 Dachschräge

4.65

9.45

9.45

DACHGESCHOSS

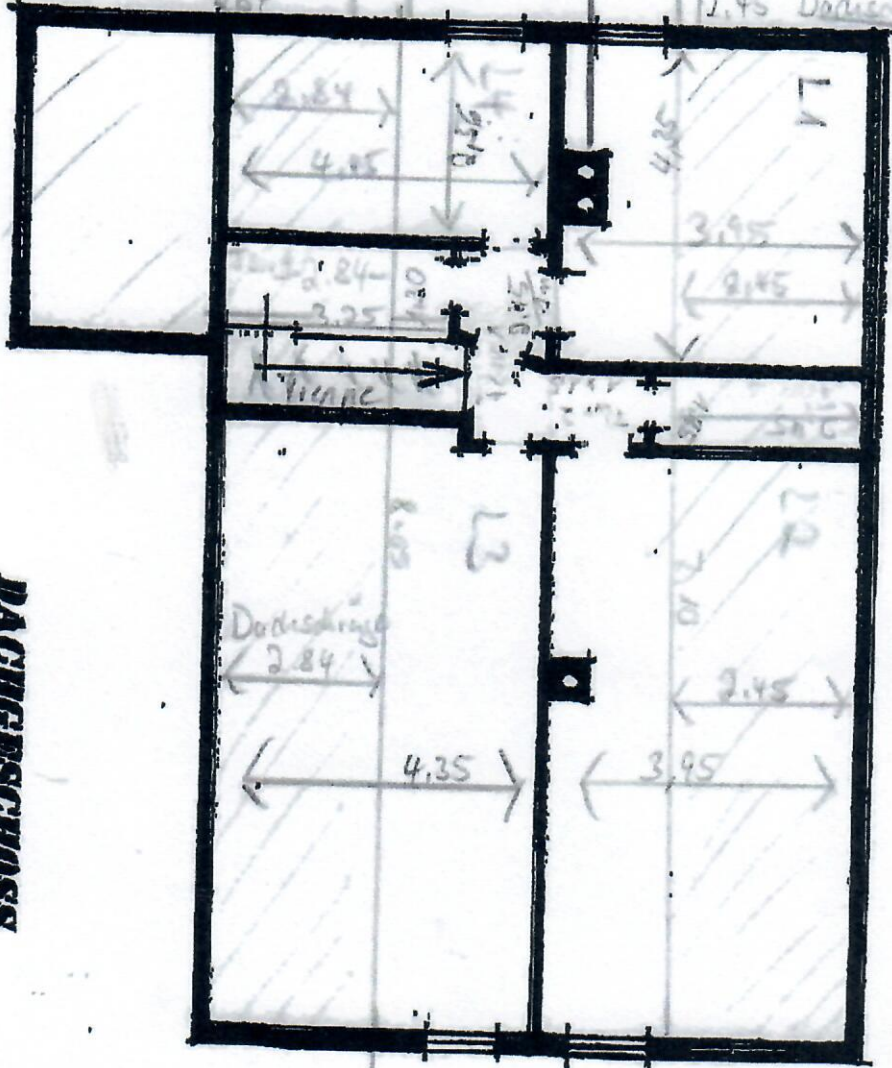

14.90