
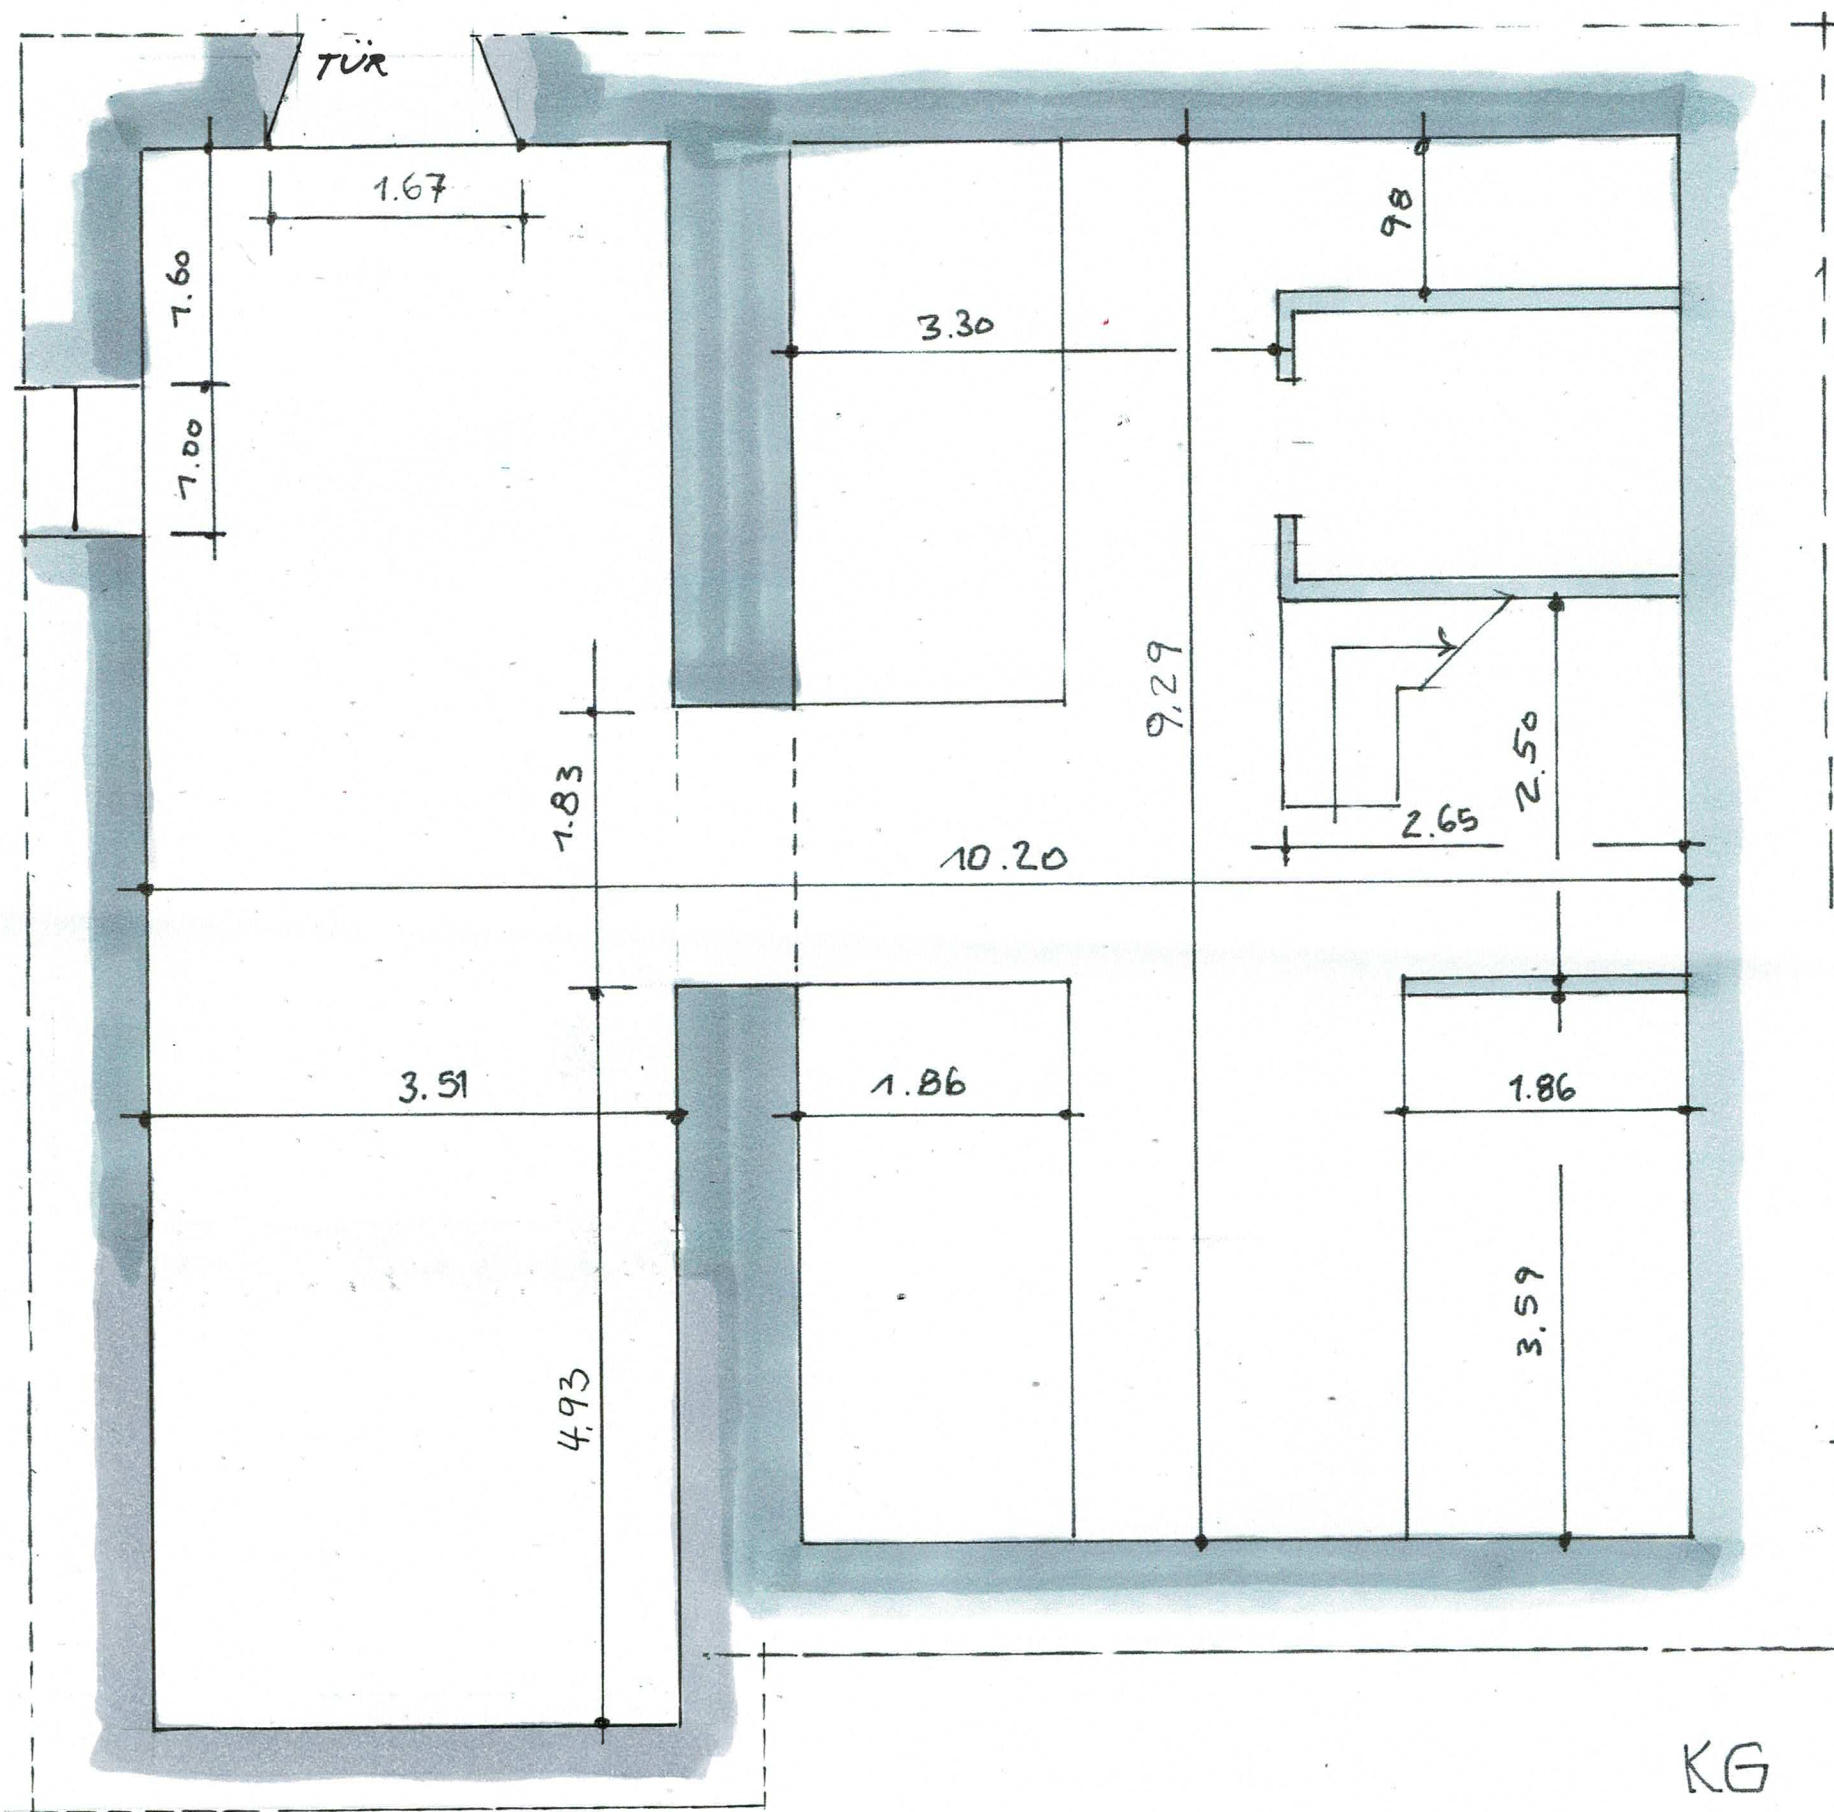


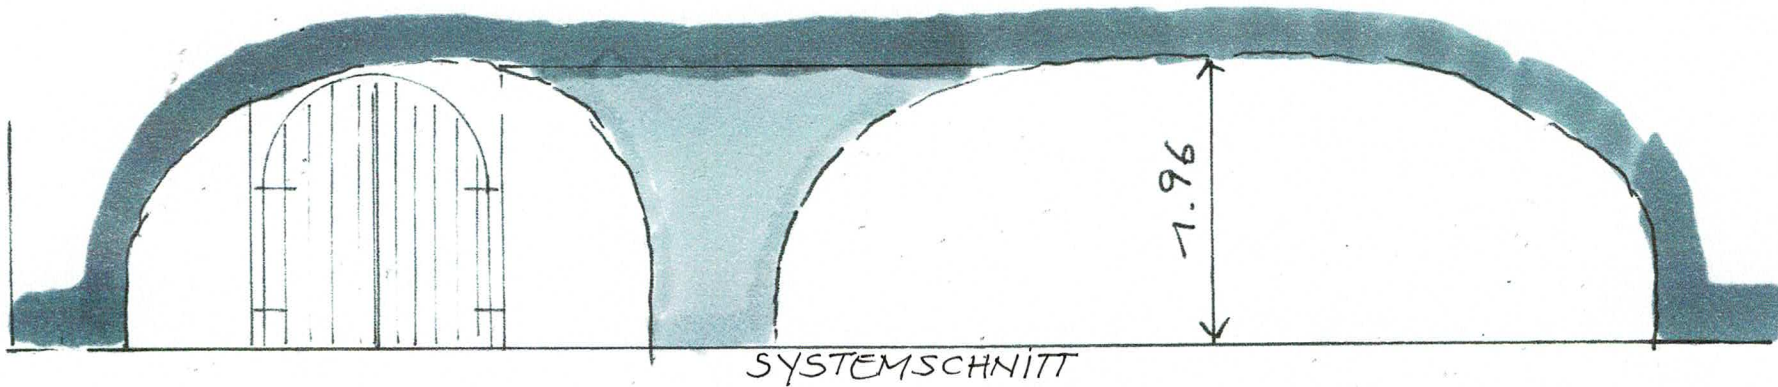

KG
M. 1:50