


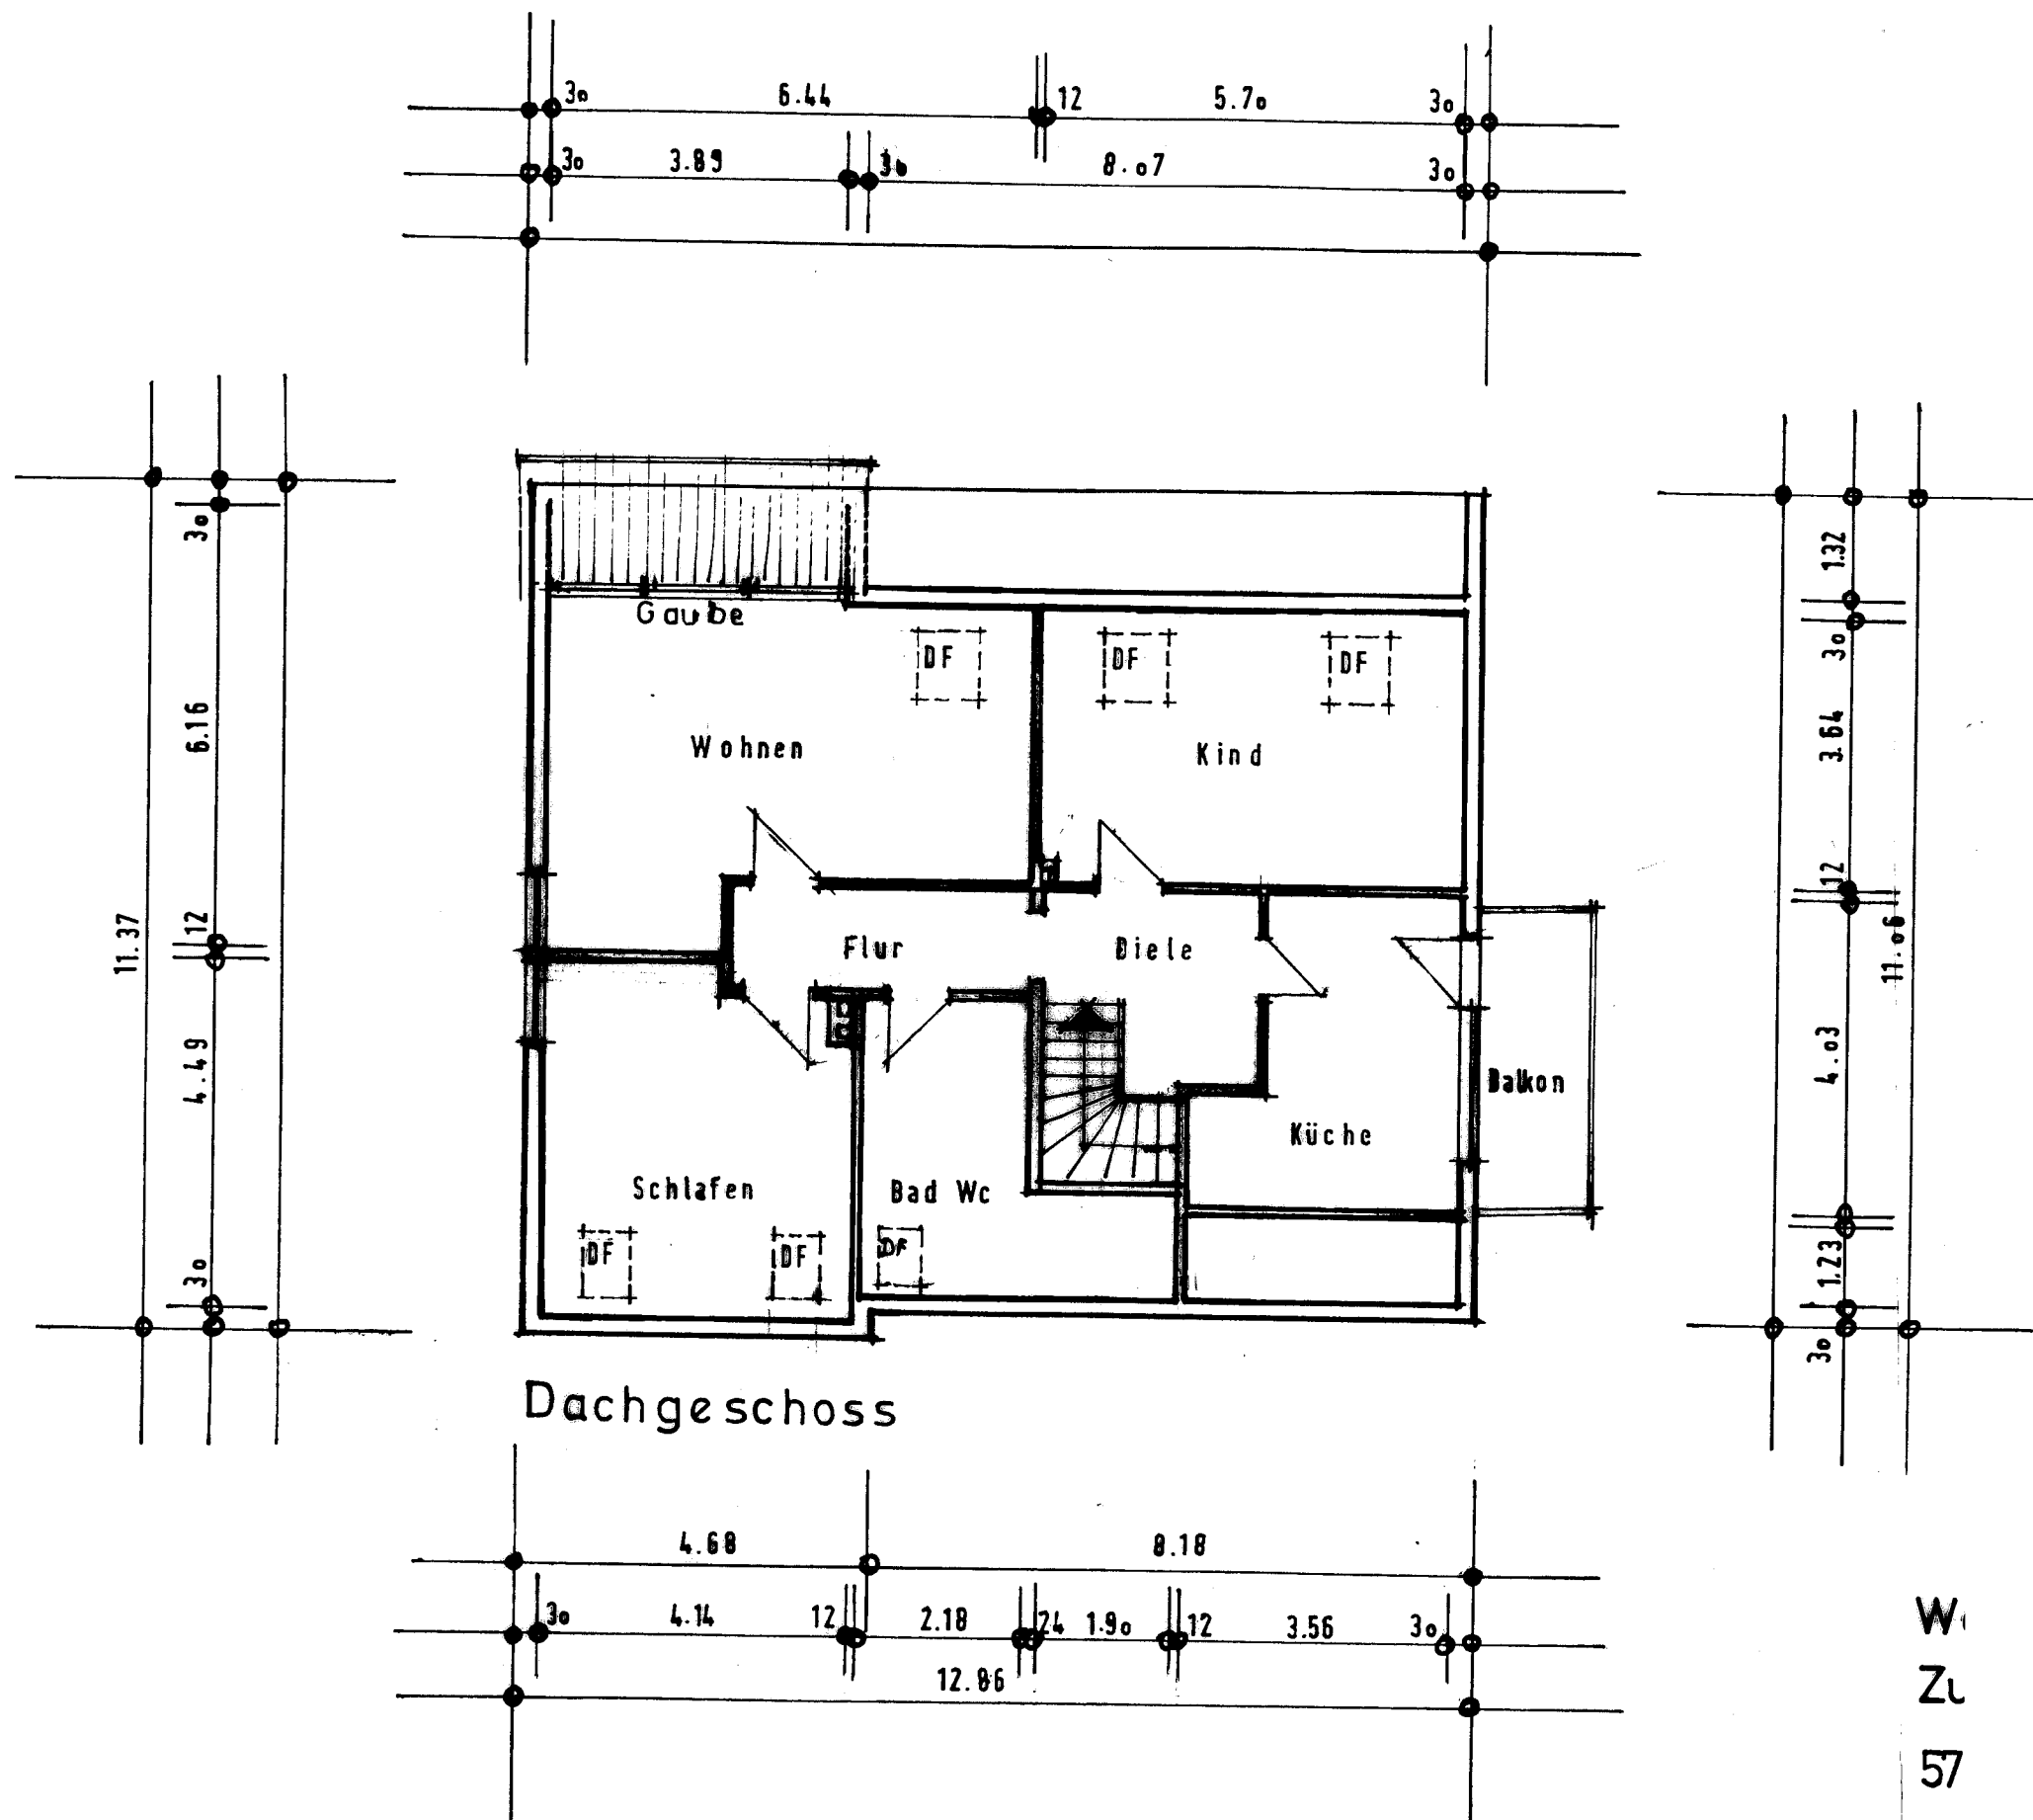

W
Z
57

S

Rückbau in
Wohnung

2021/2022

