


24 3.40 175 2.11 10 1.68 24 2.10 24 1.68 10 2.11 175 3.40 24

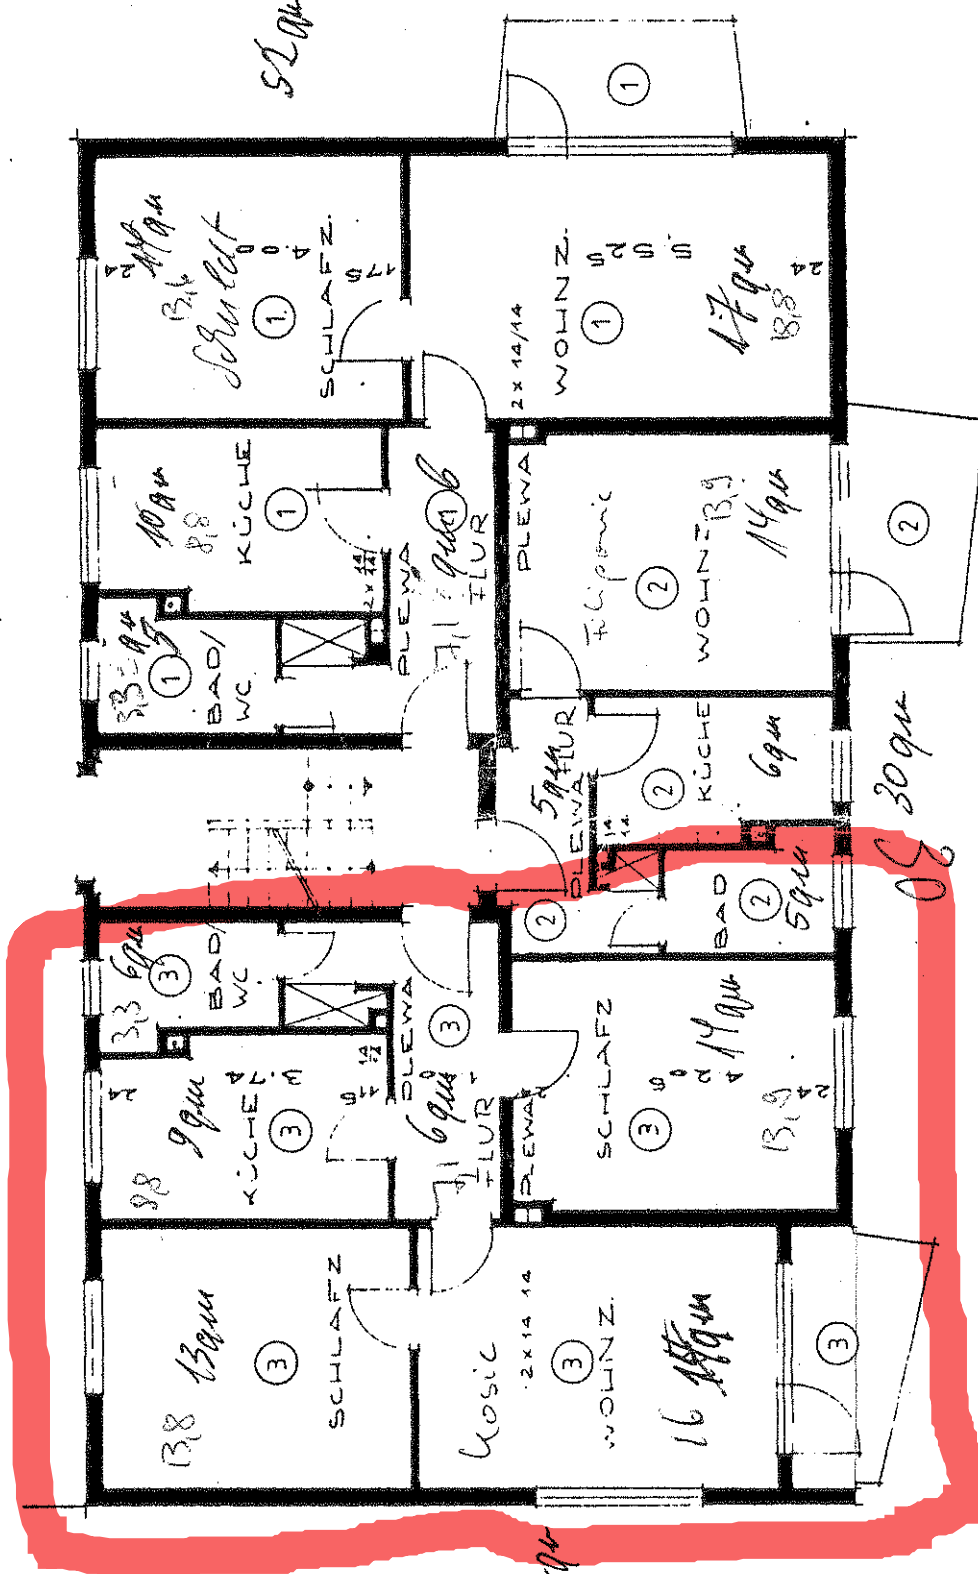

24 3.40 175 2.11 10 1.68 24 2.10 24 1.68 10 2.11 175 3.40 24

ERDGESCHOSS VHC 1-3
1. OBERGESCHOSS " 4-6

24

175

4.00

175

4.725

8.00

24

24 62qm

Q2.9

10 = 61.0

neu 63.0

51.6 m² - 3%
Balkon + Balkon

25

11.33

17.00

64.00