


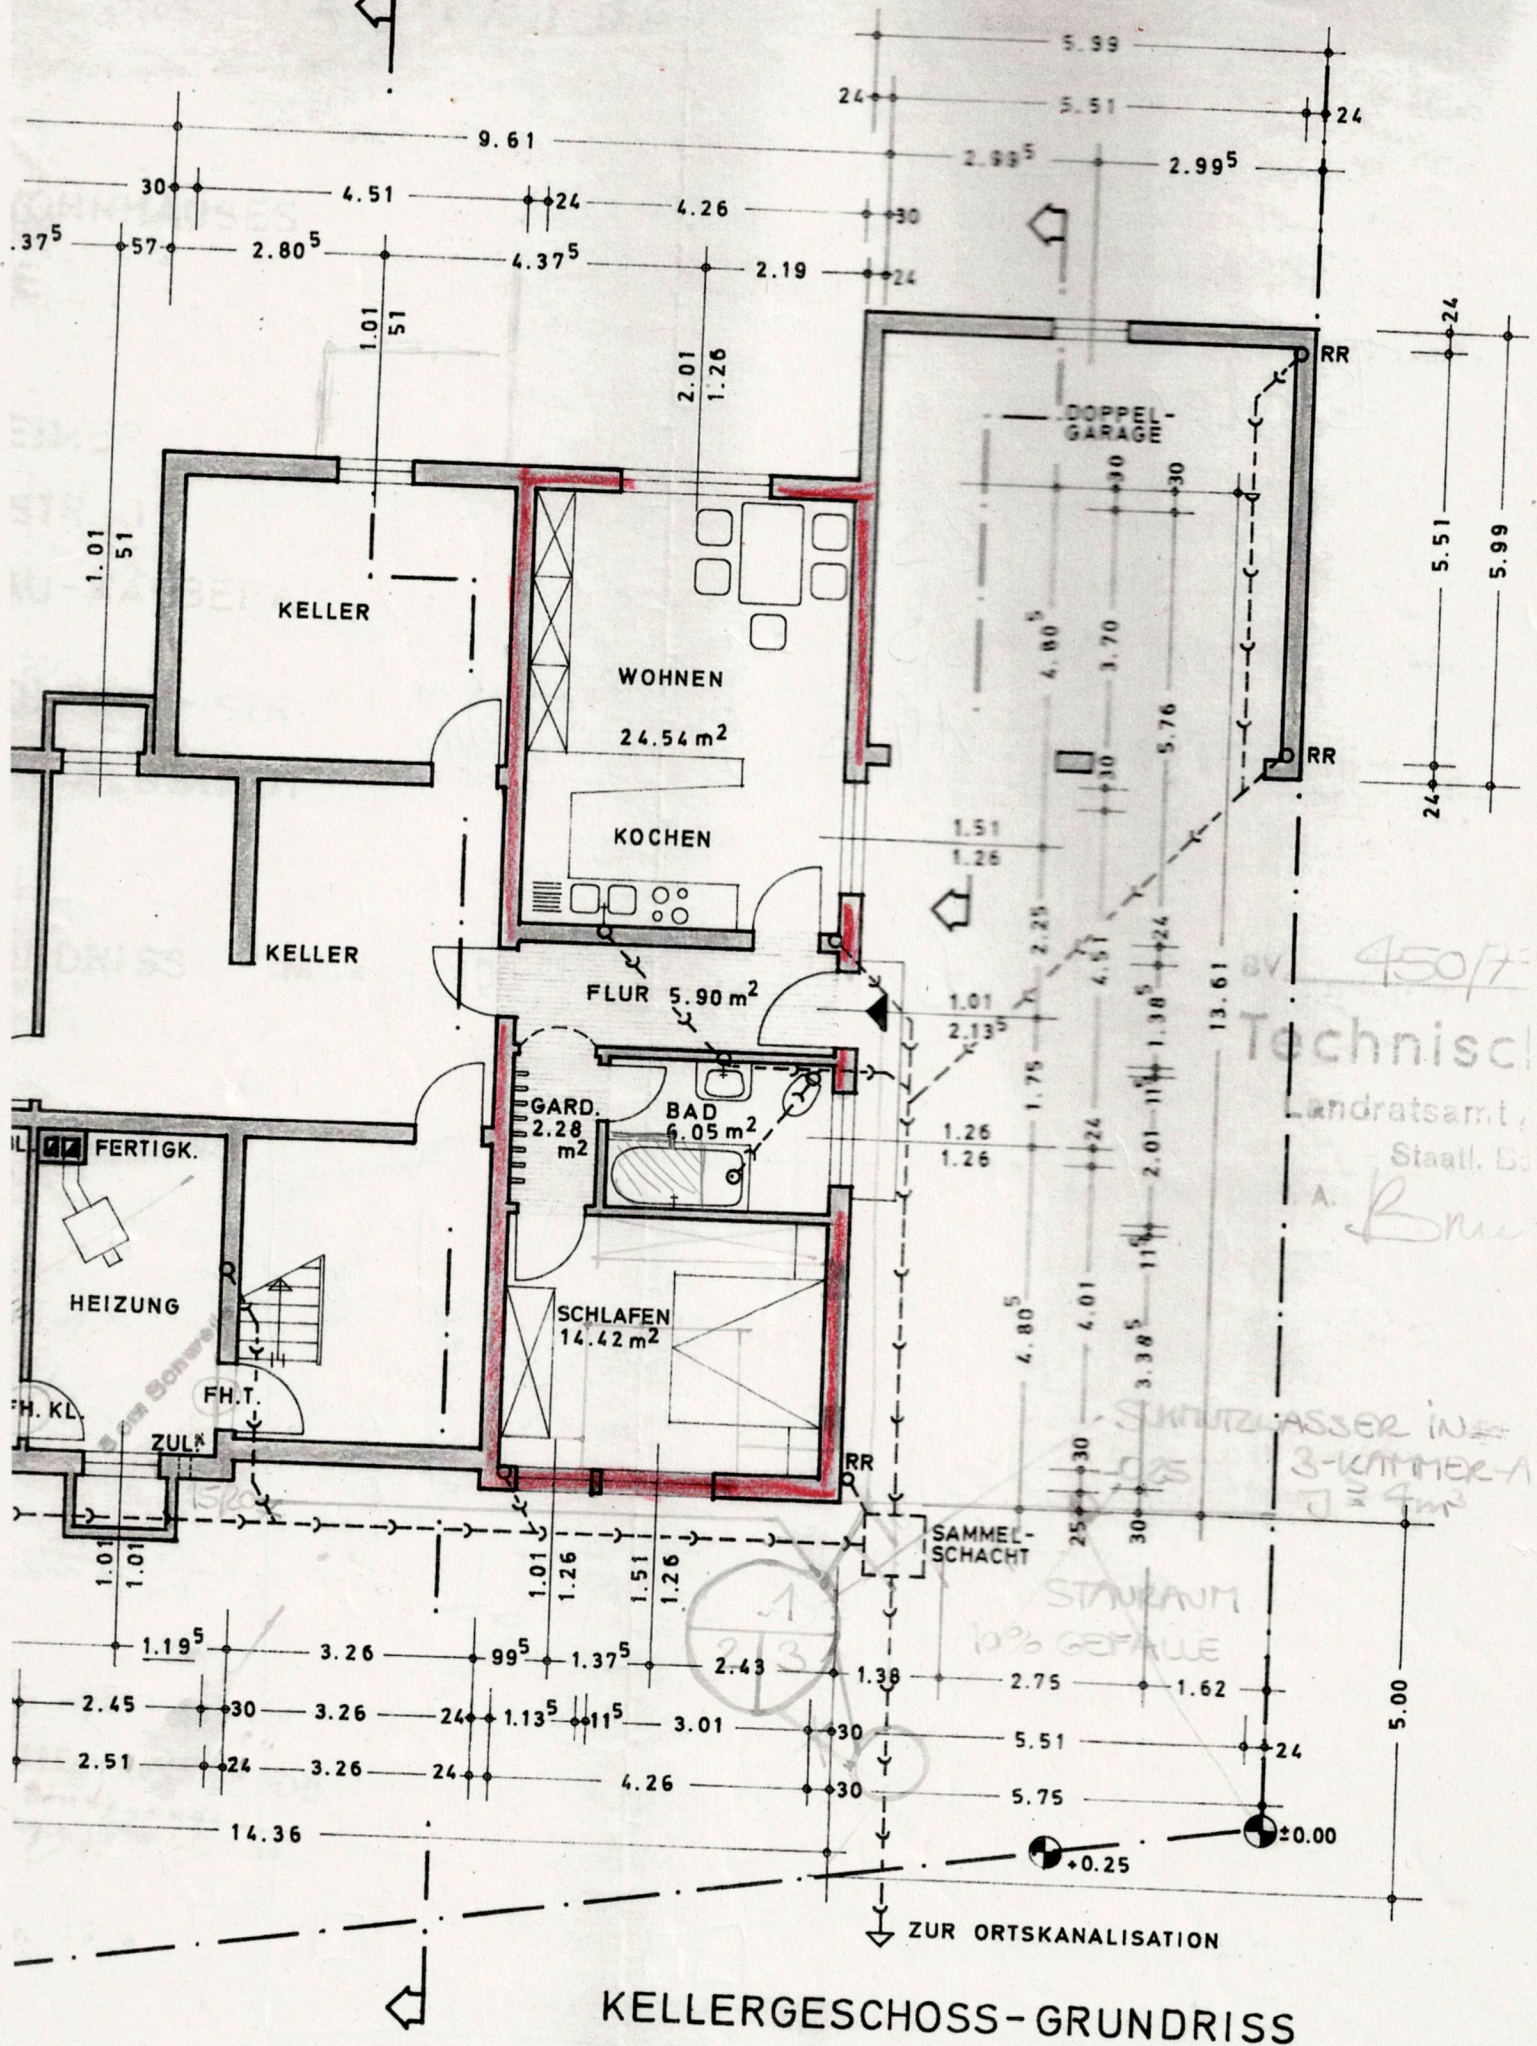

KELLERGECHOSS-GRUNDRISS