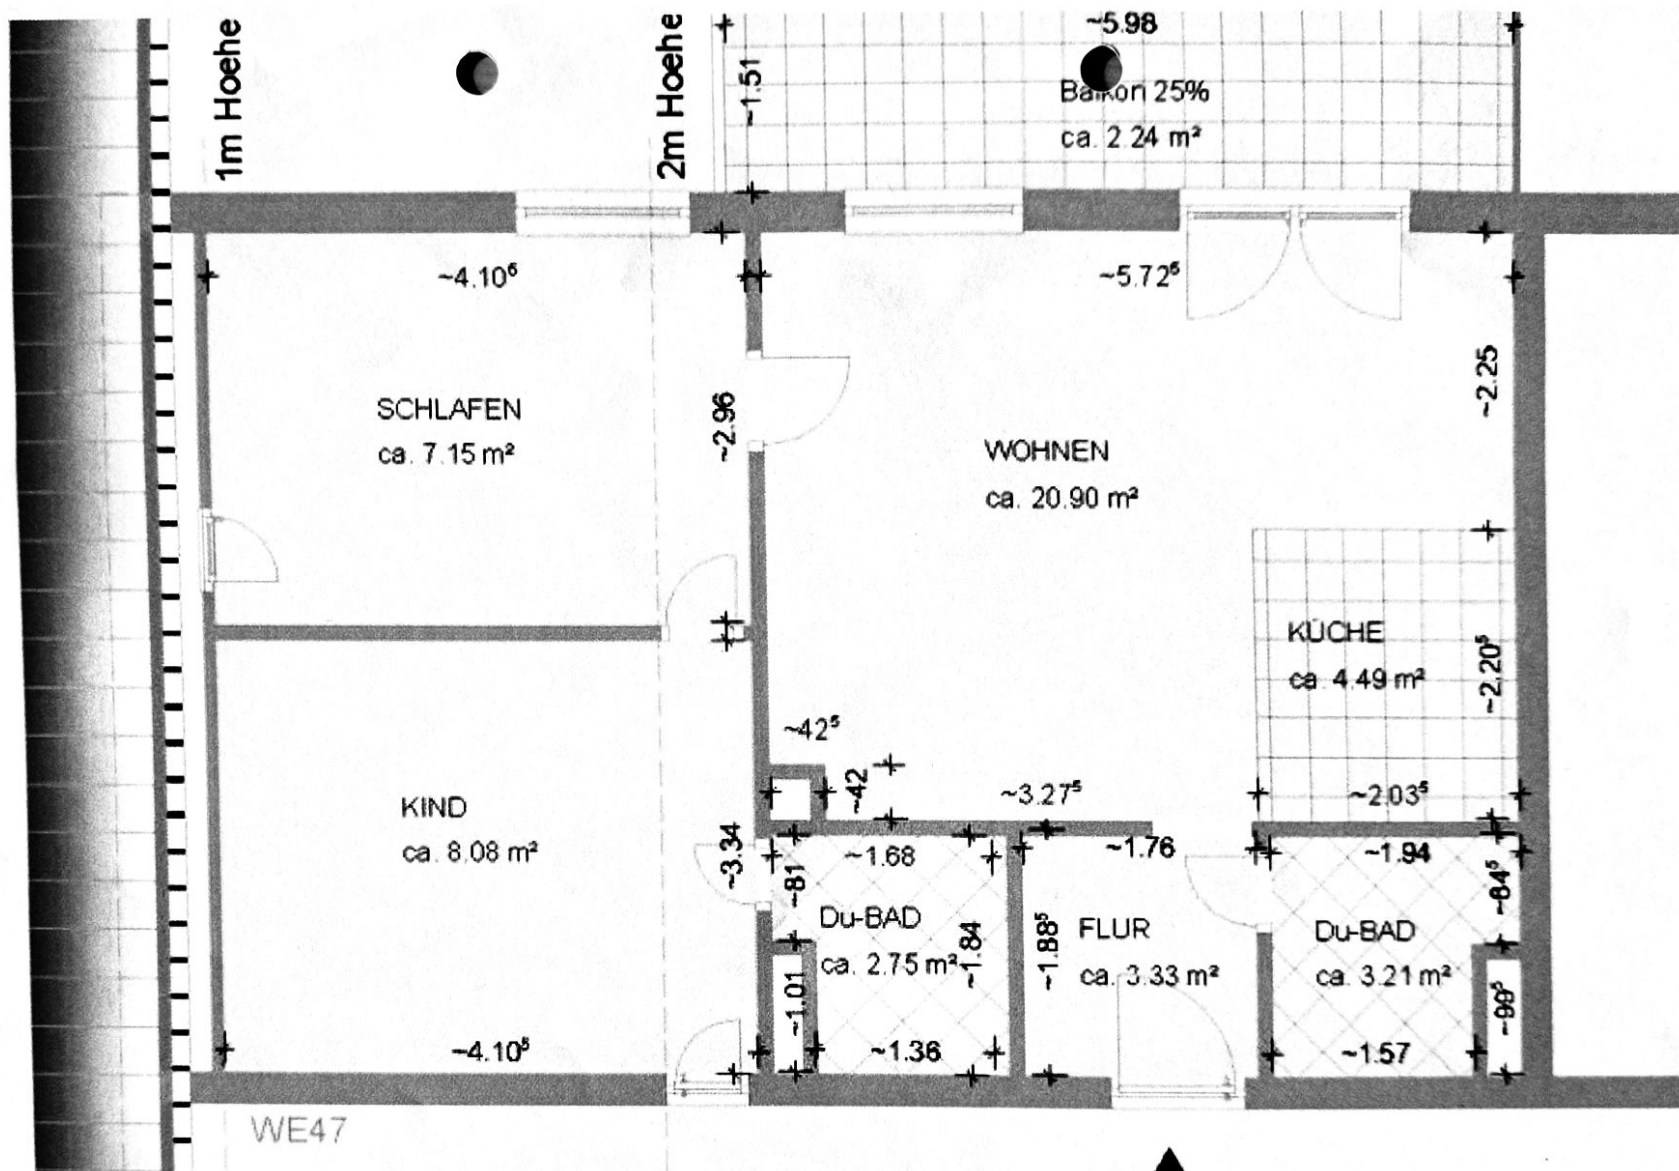




▲
EINGANG
WE47



Wohnfläche Räume	
WE47	
Balkon 25%	2.24 m²
Du-BAD	5.96 m²
FLUR	3.33 m²
KIND	8.08 m²
KÜCHE	4.49 m²
SCHLAFEN	7.15 m²

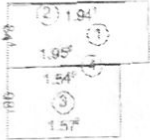
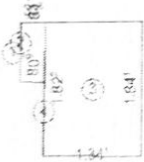
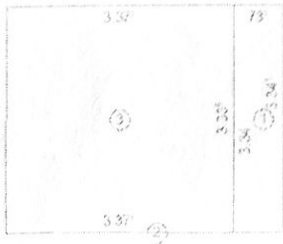
Wohn- und Zubehörflächen

Projekt: P-20-0123_SPK_23684-Scharbeutzer-Str-16

Ersteller:

Datum / Zeit: 22.09.2020 / 19:29

Hinweis: Alle Maße sind vor Ort zu prüfen.

Bezeichnung	Funktion	Nr	Abmessungen	Fläche nach WoFIV [m²]
141 - 3.OBERGESCHOSS				
Wohnfläche				
	Balkon 25%	1	0.25*(0.5* (5.982+5.979)*1.495)	2,236
		2	0.25*(0.5*(0.012*5.979))	0,009
		Summe		2,245
	Du-BAD	1	0.5*(1.959+1.941)*0.844	1,645
		2	0.5*(0.028*1.940)	0,027
		3	0.5*(1.572+1.549)*0.981	1,530
		4	0.5*(1.549*0.014)	0,011
		Summe		3,213
	Du-BAD	1	0.5*(0.813+0.809)*0.336	0,272
		2	0.5*(0.809*0.004)	0,002
		3	0.5*(1.841+1.822)*1.341	2,456
		4	0.5*(0.019*1.822)	0,018
		Summe		2,748
	FLUR	1	0.5*(1.900+1.883)*1.758	3,326
		2	0.5*(1.883*0.003)	0,003
		Summe		3,329
	KIND	1	0.5*(3.341+3.340)*0.733	2,448
		2	0.5*(0.5*(0.004*3.375))	0,003
		3	0.5*(0.5* (3.375+3.371)*3.336)	5,625
		Summe		8,076

Projekt: P-20-0123_SPK_23684-Scharbeutzer-Str-16
Ersteller:
Datum / Zeit: 22.09.2020 / 19:29
Hinweis: Alle Maße sind vor Ort zu prüfen.

52,150

52,150

52,150

Wohn- Zubehörfläche	Wohnfläche	Total
141 - 3.OBERGESCHOSS	52,150	52,150
Total	52,150	52,150