


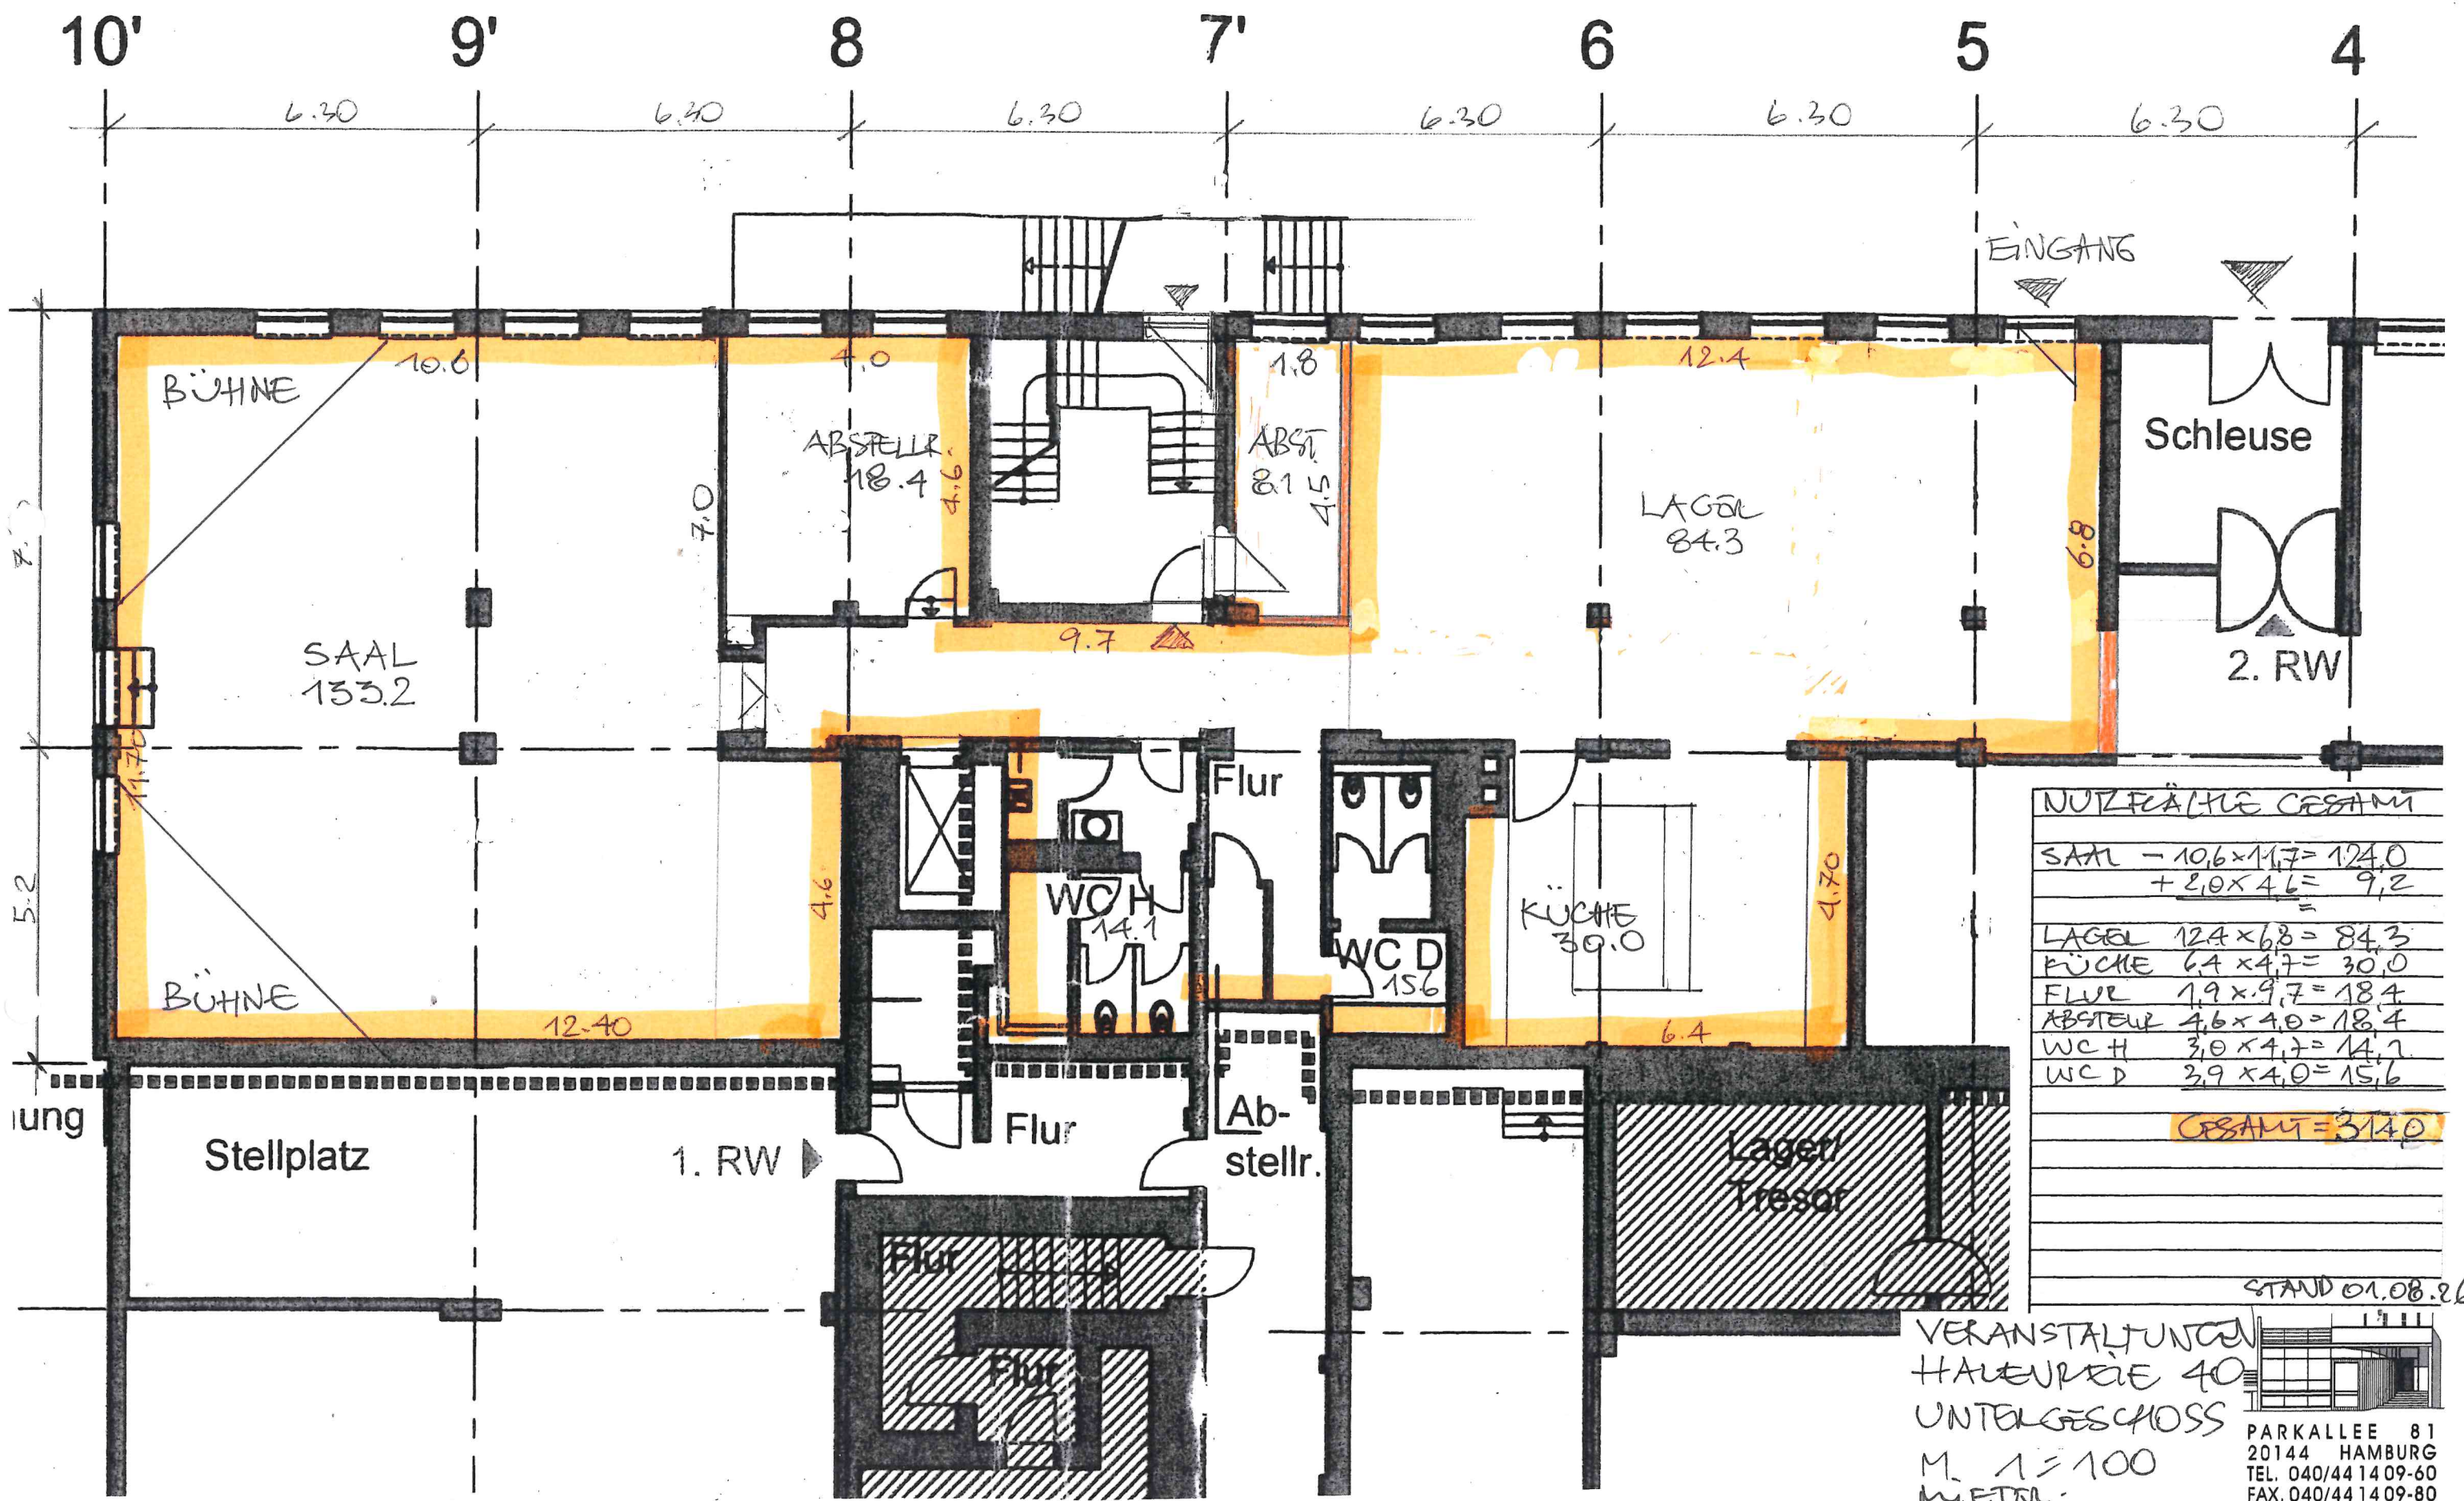

NUTZFLÄCHE GESAMT	
SAAL	$10,6 \times 11,7 = 124,0$
	$+ 2,0 \times 4,6 = 9,2$
	=
LAGER	$12,4 \times 6,8 = 84,3$
KÜCHE	$6,4 \times 4,7 = 30,0$
FLUR	$1,9 \times 9,7 = 18,4$
ABSTELLR.	$4,6 \times 4,0 = 18,4$
WC H	$3,0 \times 4,7 = 14,1$
WC D	$3,9 \times 4,0 = 15,6$
GESAMT = 314,0	

STAND 01.08.86

VERANSTALTUNGEN
UNTERGESCHOSS
M. 1 = 100
MIETEL:
ELHAM AZIMI

PARKALLEE 81
20144 HAMBURG
TEL. 040/44 14 09-60
FAX. 040/44 14 09-80
Info@r-olszowka.de
www.r-olszowka.de

ARCHITEKTURBÜRO
OLSZOWKA