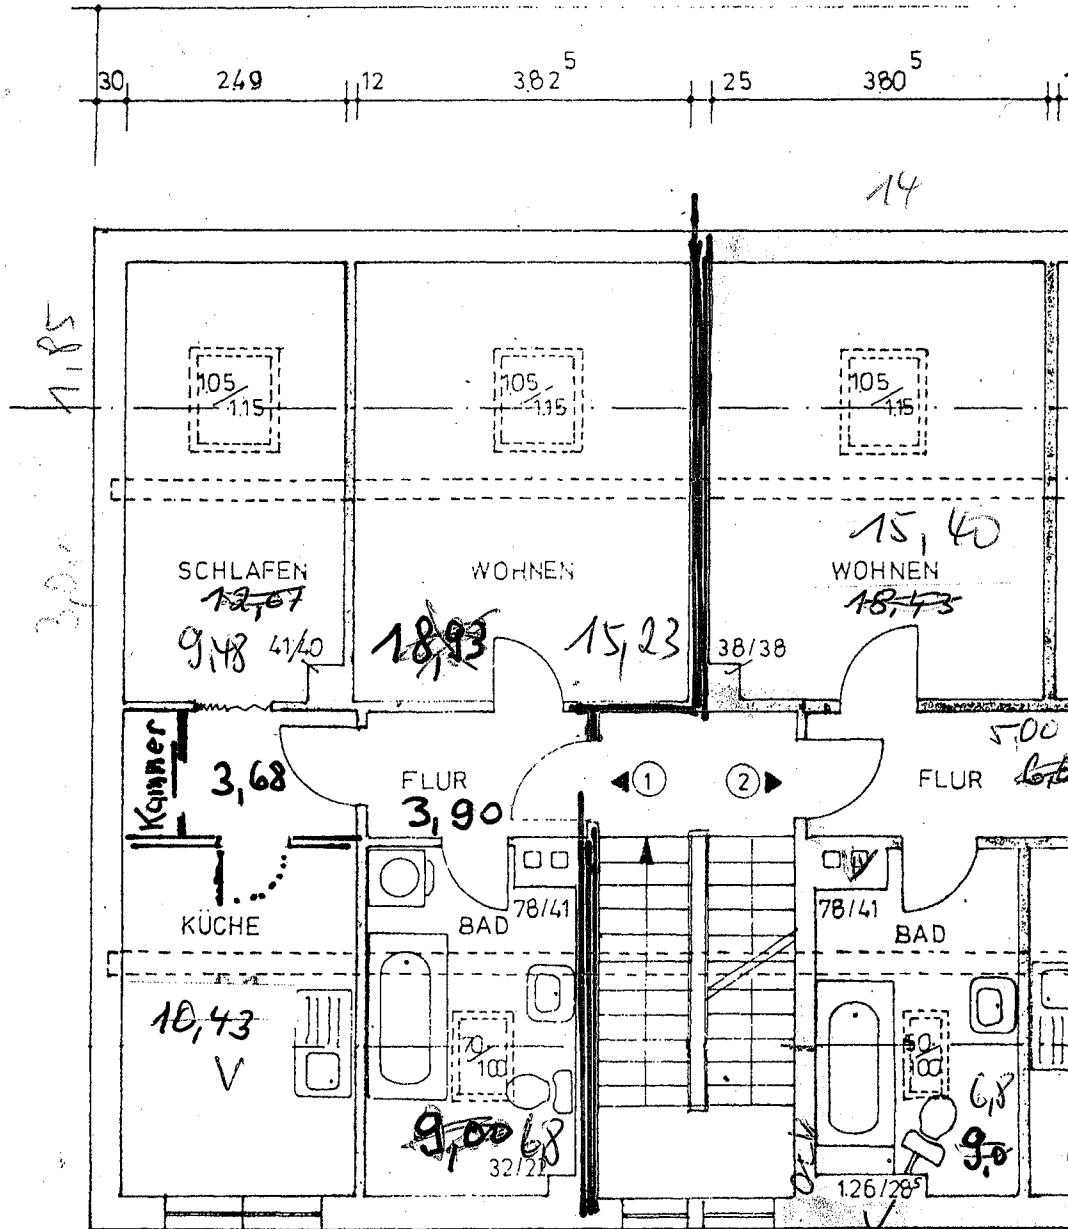
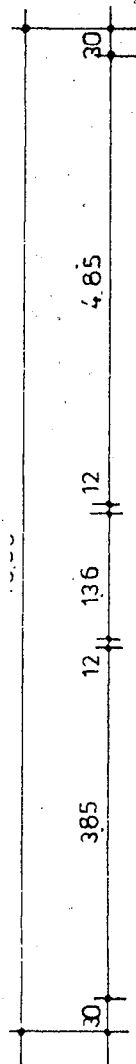


$$DG \text{ Pi} = 58 \text{ m}^2 \quad 49,50 \sim 50 \text{ m}^2$$

$$= 48 \times 9,50 = 456,50$$

GRUNDRISS DACHGESCHOSS

$$DG \text{ K} = 56 \text{ m}^2 \quad 47,11$$

$$48 \times 9,50 = 456,50$$