


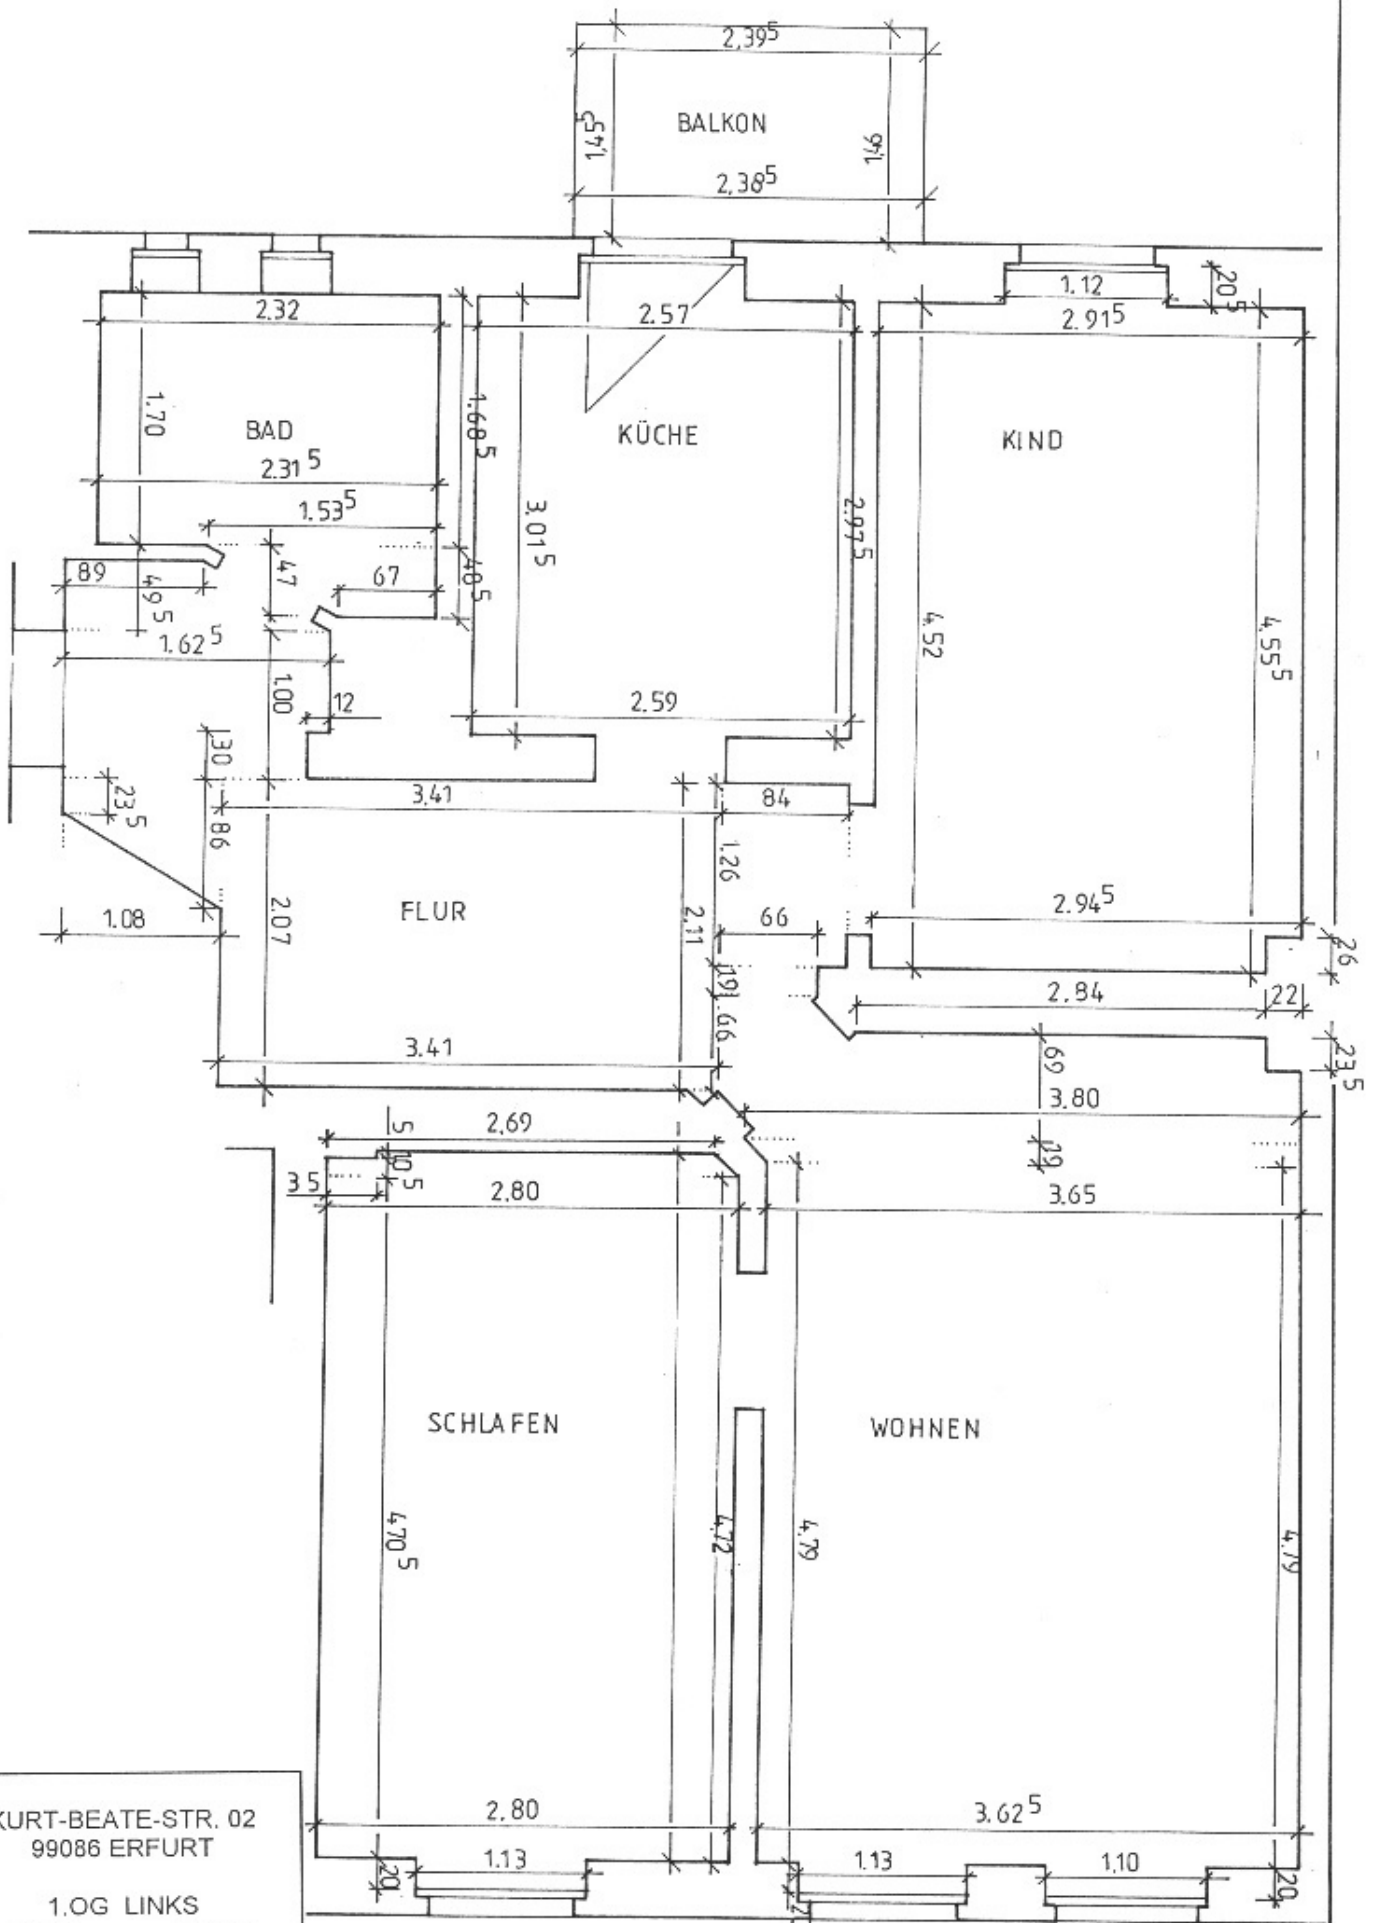

KURT-BEATE-STR. 02
99086 ERFURT

1.OG LINKS
WE 11 M 1:50