


39.60<sup>5</sup>

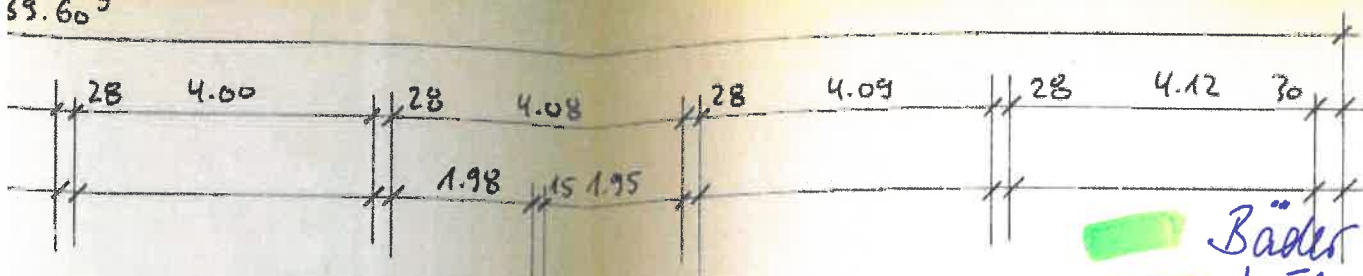

Bäder  
Küche

