


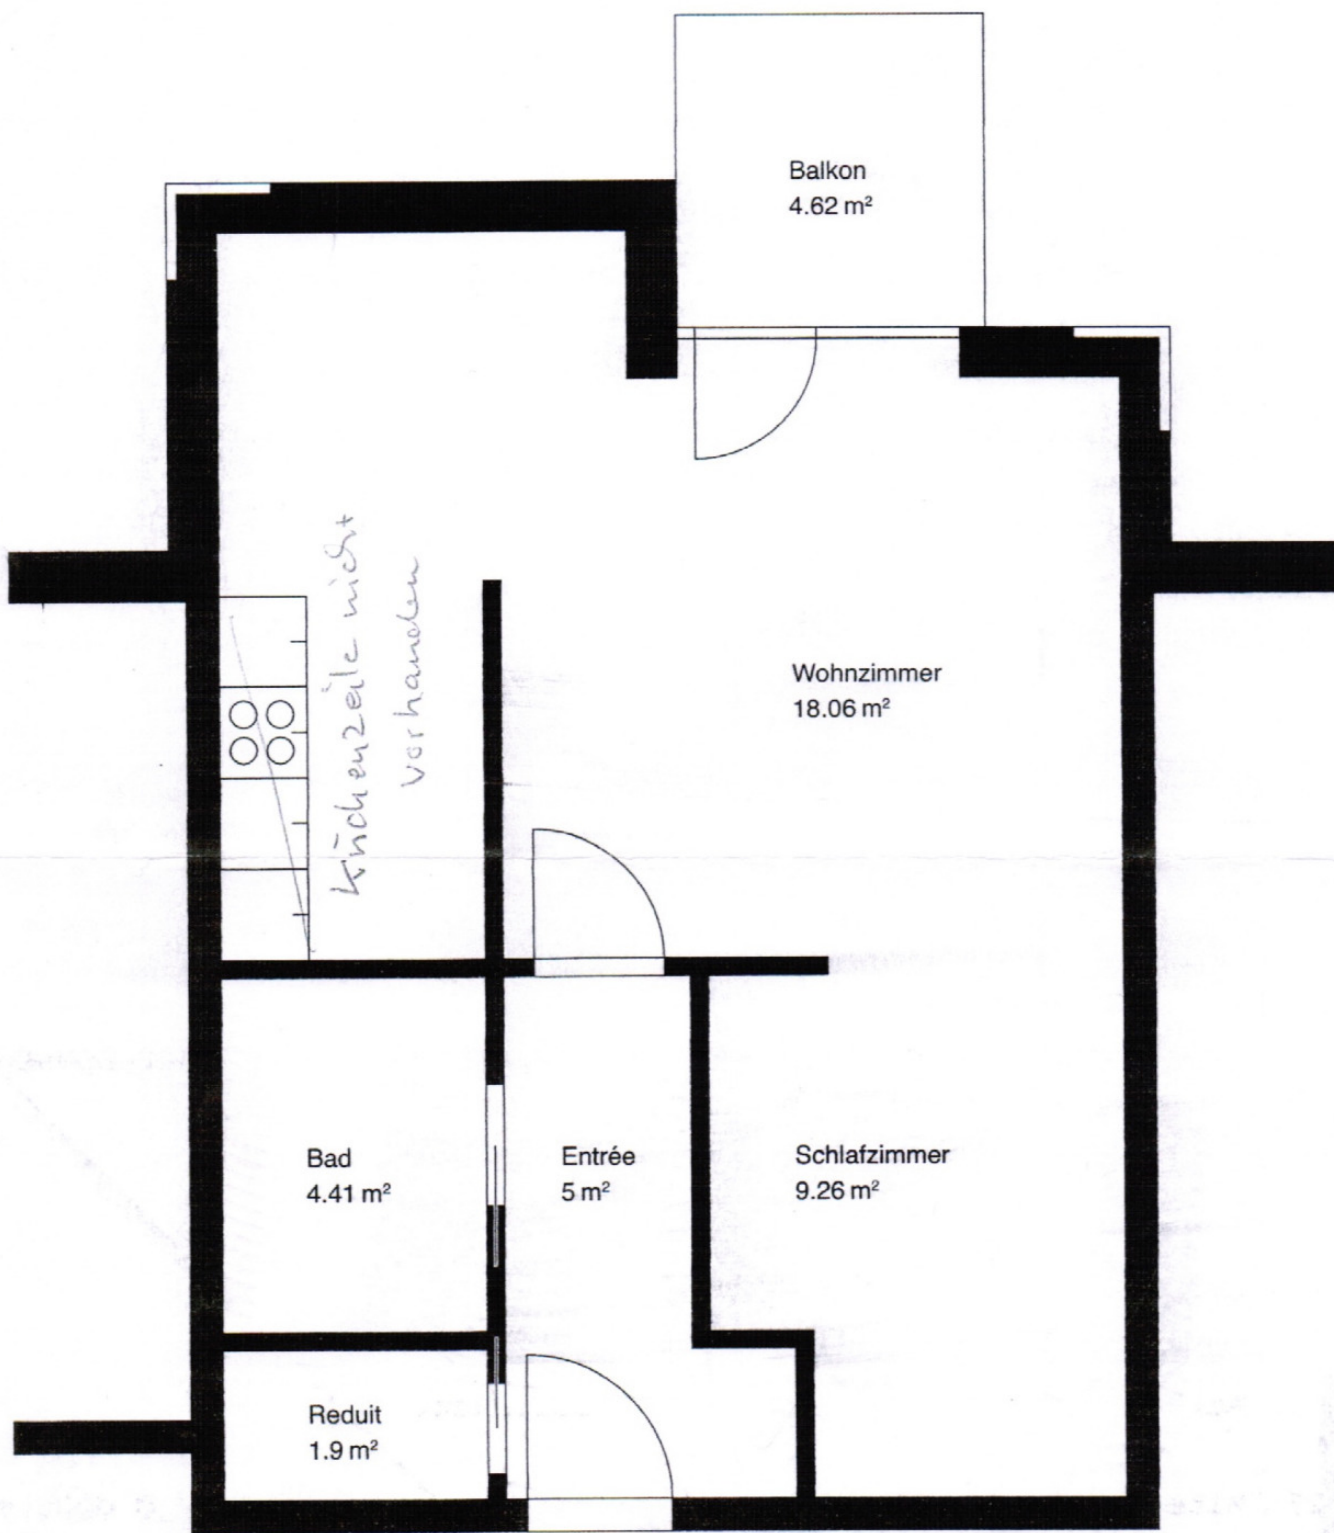

Eingang

0 m 1 m 2 m

Massstab 1 : 50