


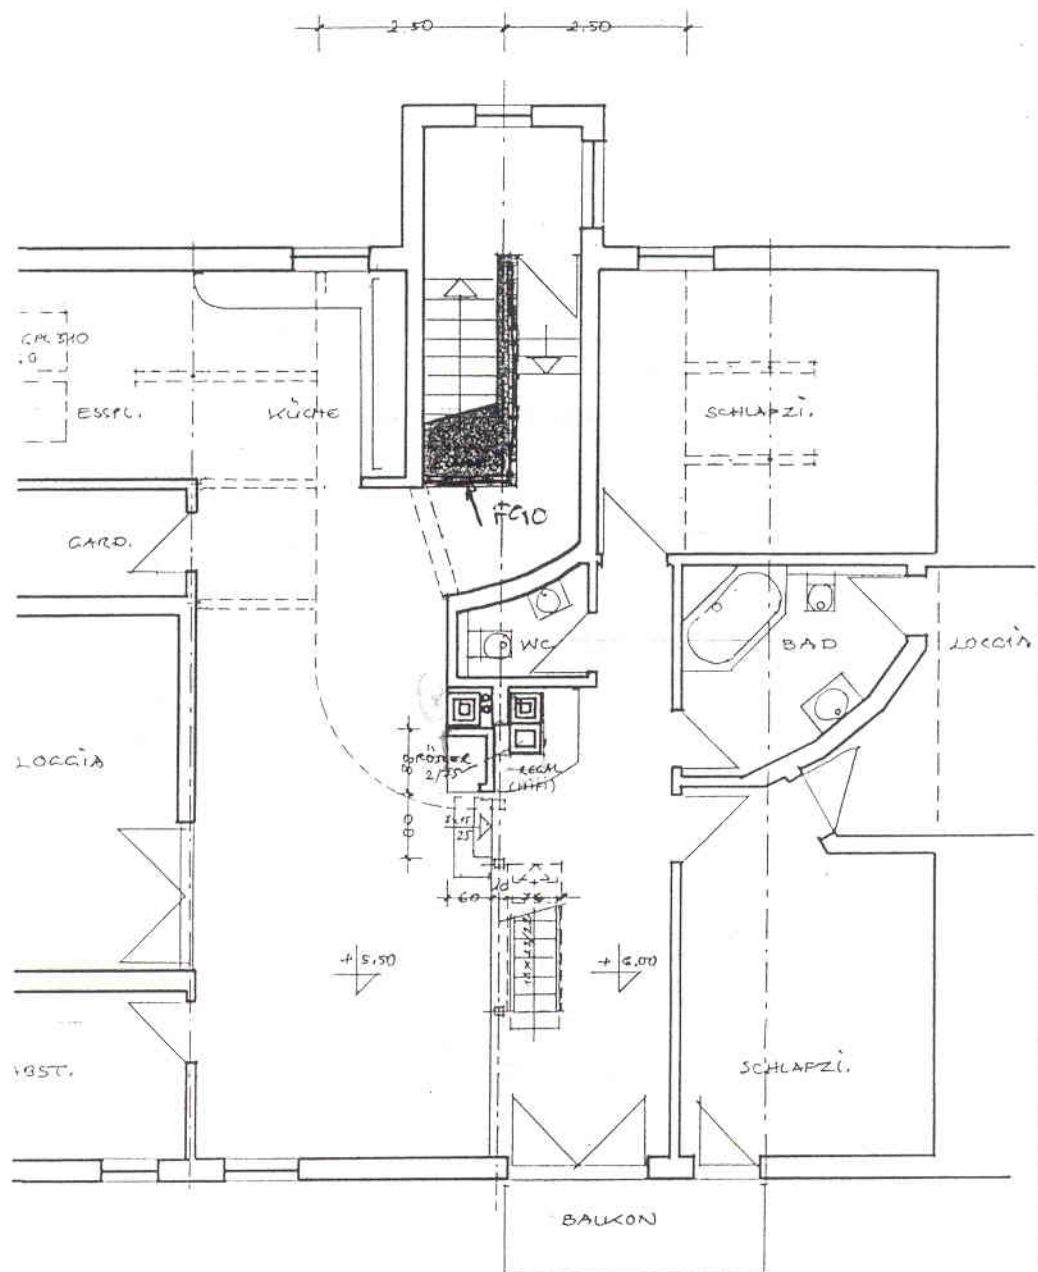

WOHNHAUS RHEINHÖHE/ OBERWINTER
DECKBLATT DC +5.50/6.00 M. 1/50

DDG1


30.07.77 T₈ 4

Reismann · Samland & Partner





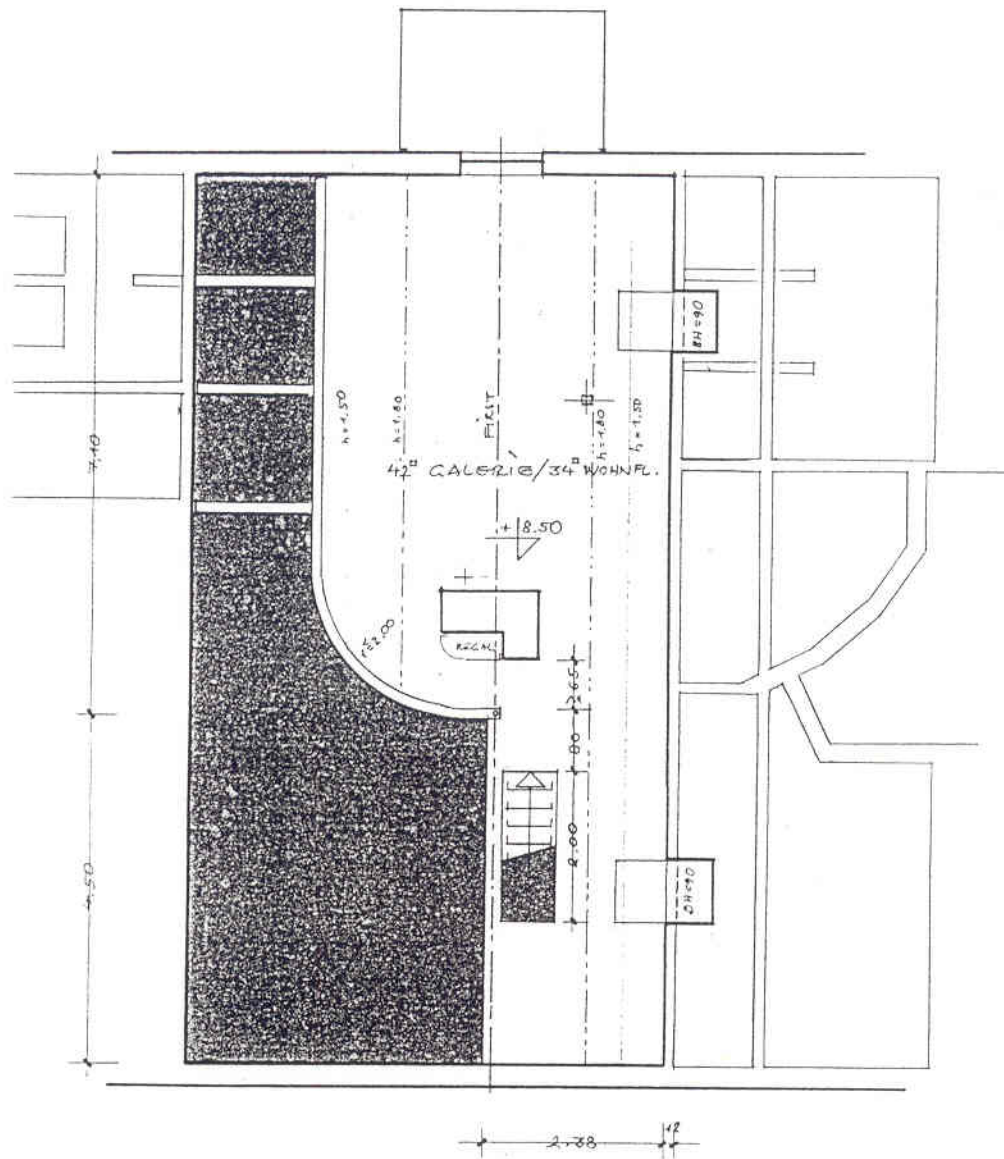

WOHNHAUS RHEINHÖHE / OBERWINTER
DECKBLATT DG / GALERIE, M.1/50

DDG₂


30.07 97 T₈ 5

Belmann · Samland & Partner





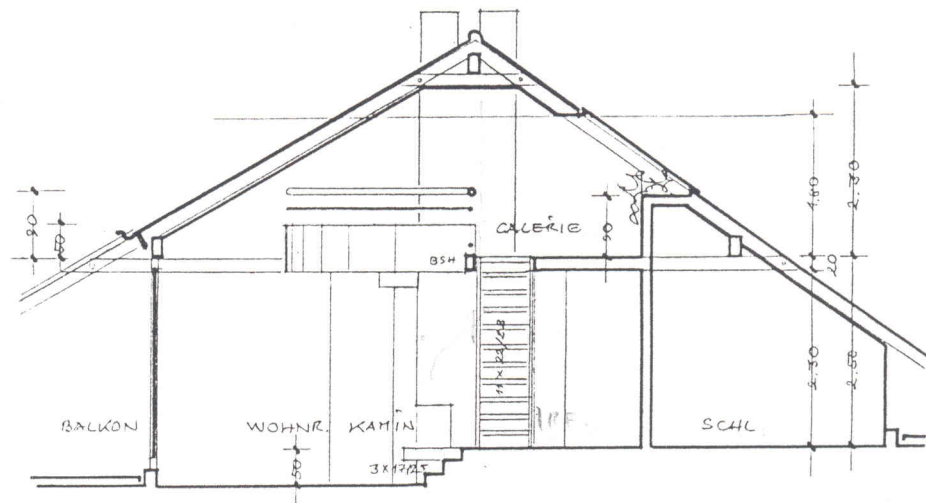

WOHNHAUS RHEINHÖHE / OBERWINTER
 DG / GALERIE
 M. 1/50

SCHNITT

30.07.97 T 6

Reismann · Samland & Partner





DG	Wohnraum	32.0	
	Studio	15.0	
	Galerie	28.0	75.0
	Küche/EBplatz	15.5	
	Kammer	6.0	
	Schlafzimmer	15.0	
	Zimmer	13.5	
	Bad	6.0	
	Gäste-WC	1.5	
	Flur	2.0	
	Abst./Garderobe	3.5	
	Terrasse 0 1/4	2.0	
	" W "	3.5	
	Balkon "	1.0	144.5 m ²

Wohnflächen insgesamt

505.0 m²

=====


- Architekt -