


II. OG,
rechts

Falckstr.

12,

24103

KIEL

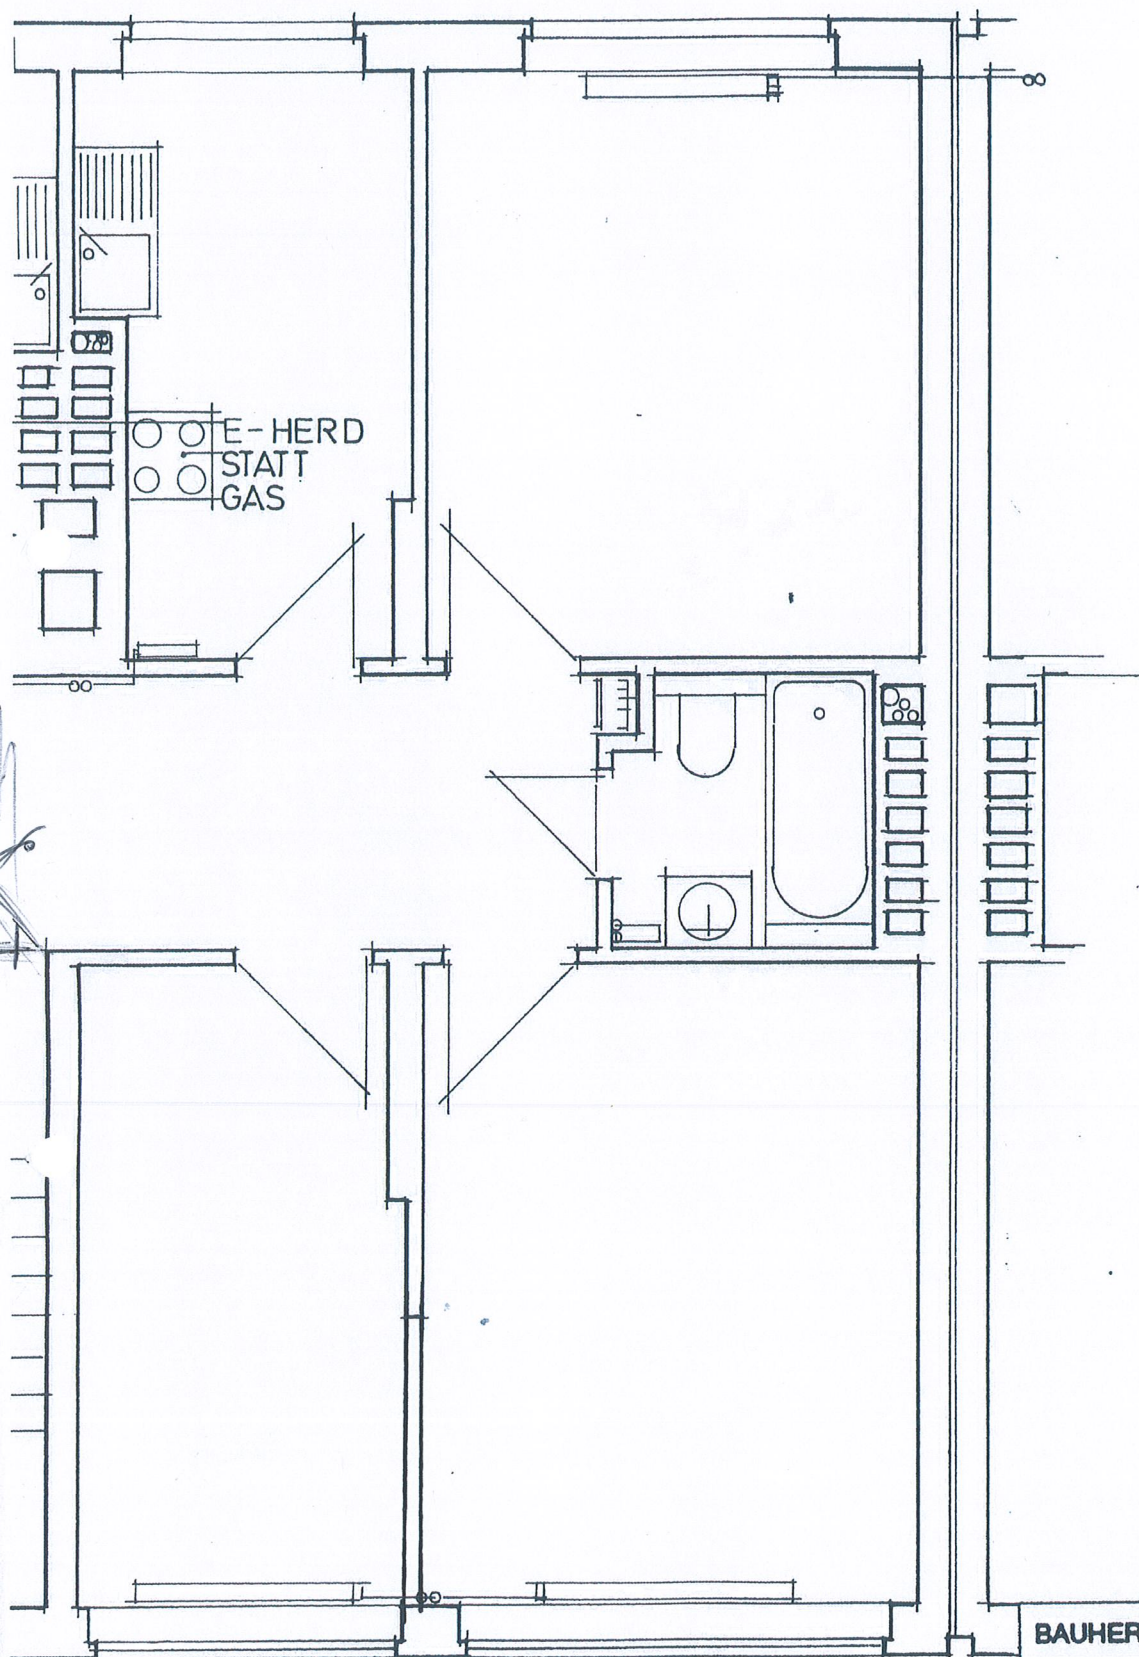

BAUHERR: R. ROHWER

ARCHITEKTEN HERTZSCH + PARTNER
SCHWESTER-THERESE-STR. 19, 24
TEL. 36 20 44 MI

FALCKSTR. 10 / 12

EG. - 3. OG
W - SANIFRUNG

MAßSTAB
1:50