


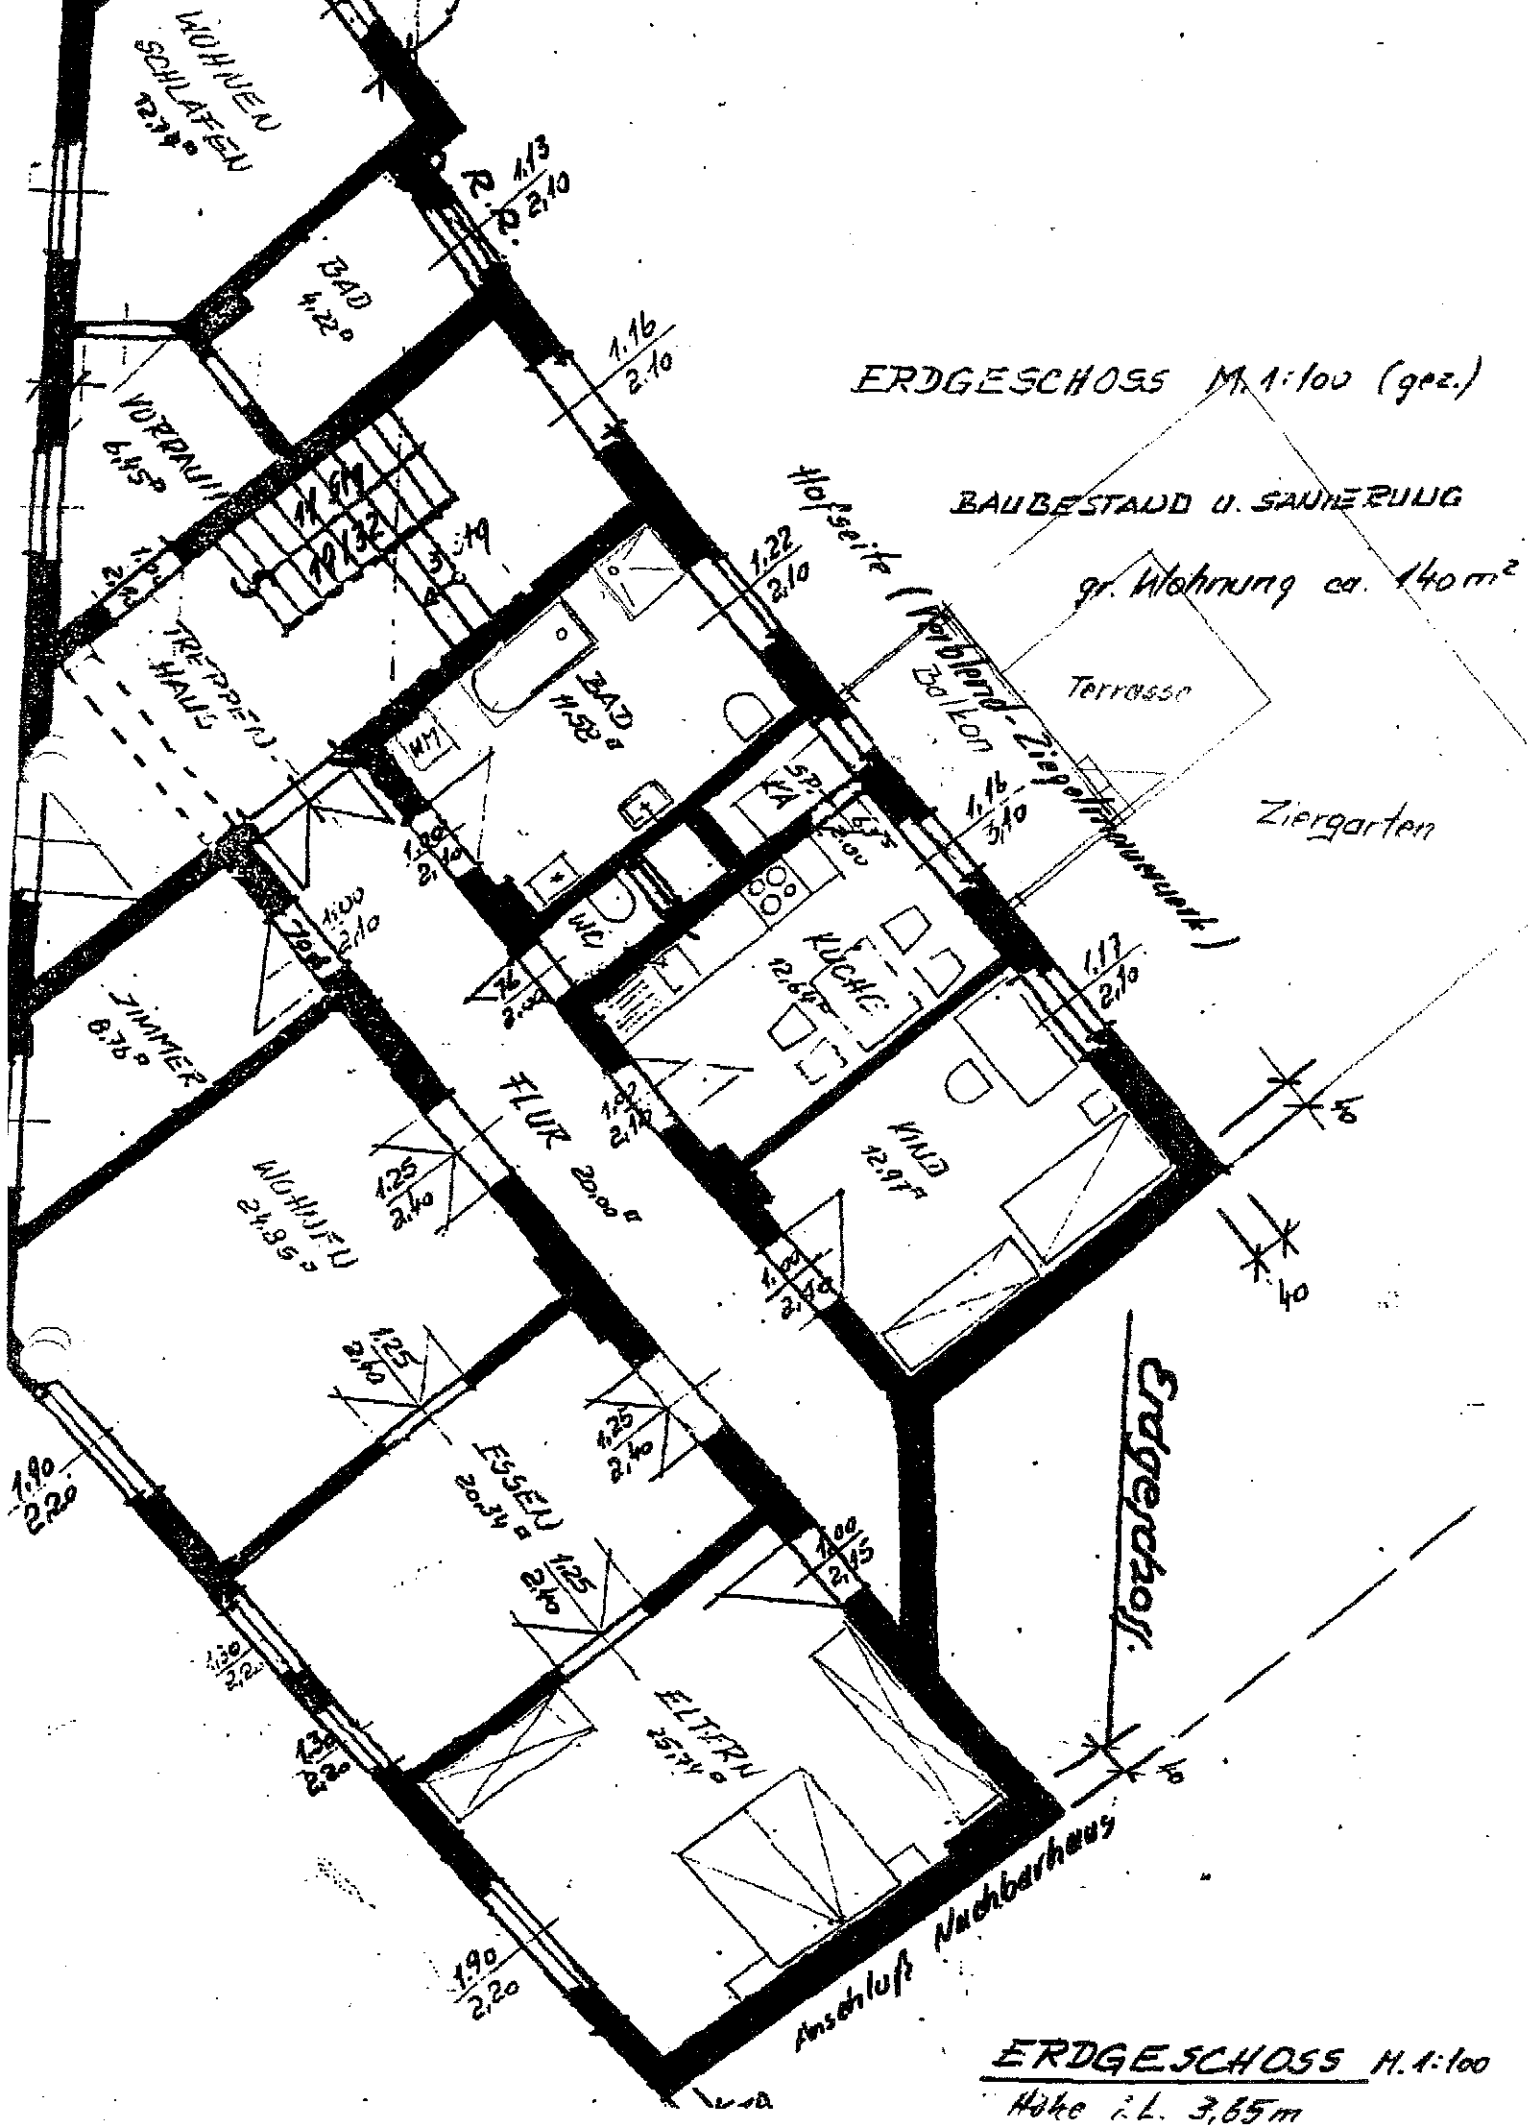

ERDGESCHOSS M. 1:100

Woke i.L. 3,65m