
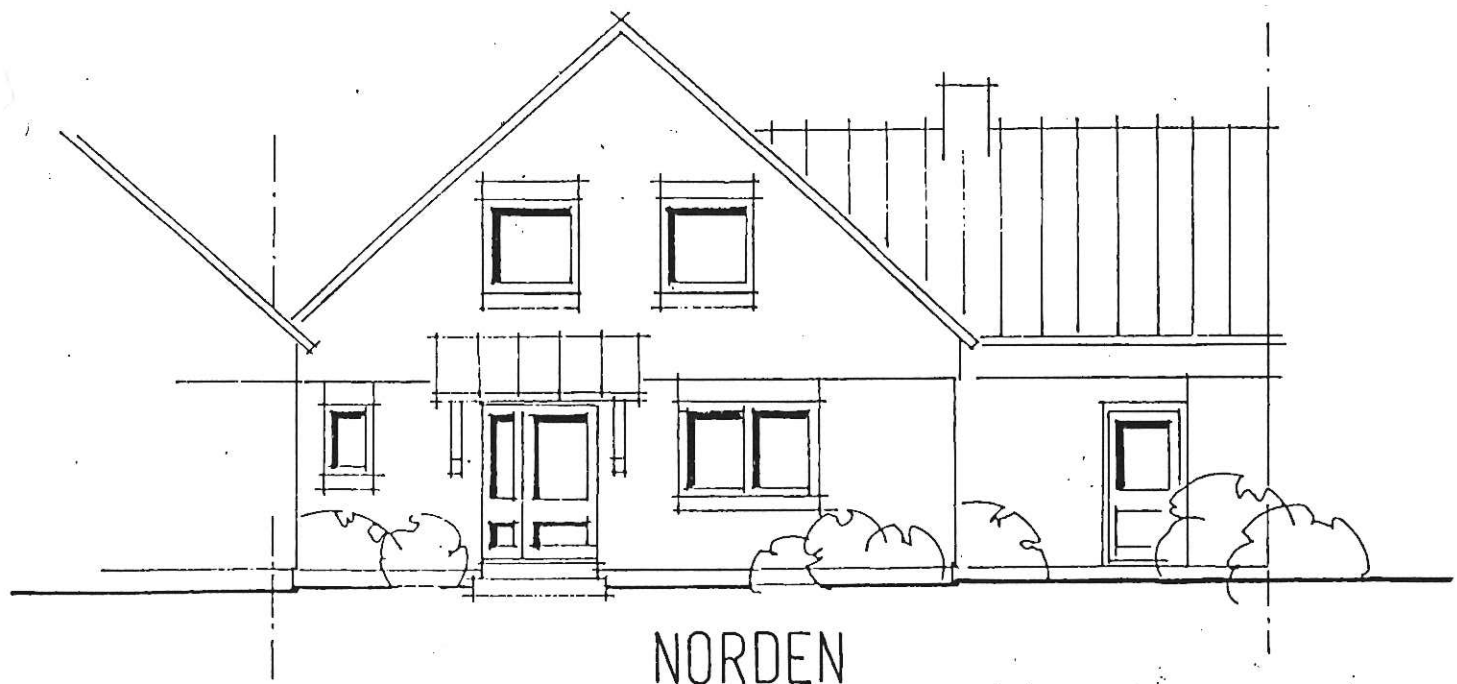


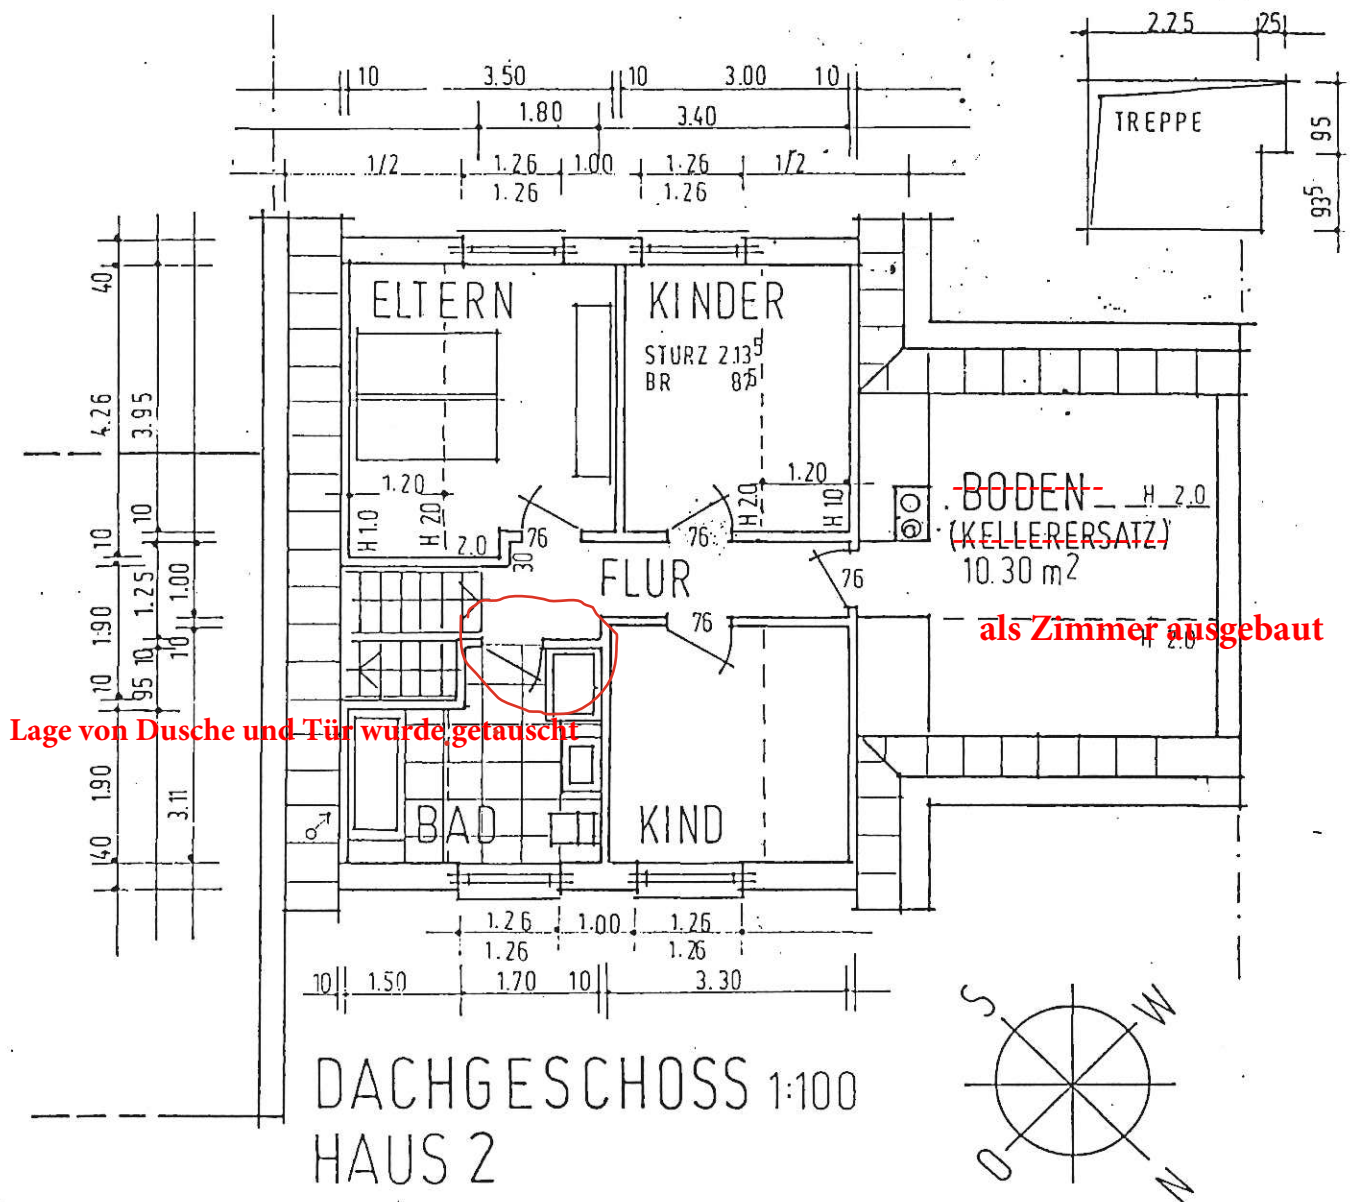

ROLF KOCH DIPLOMINGENIEUR
FREISCHAFFENDER ARCHITEKT
FLENSBURGER STR. 43 • 23411 KAPEL • 04618/1555
WINDEBYER WEG 38 • 2330 ECKHOF • 04618/5074