


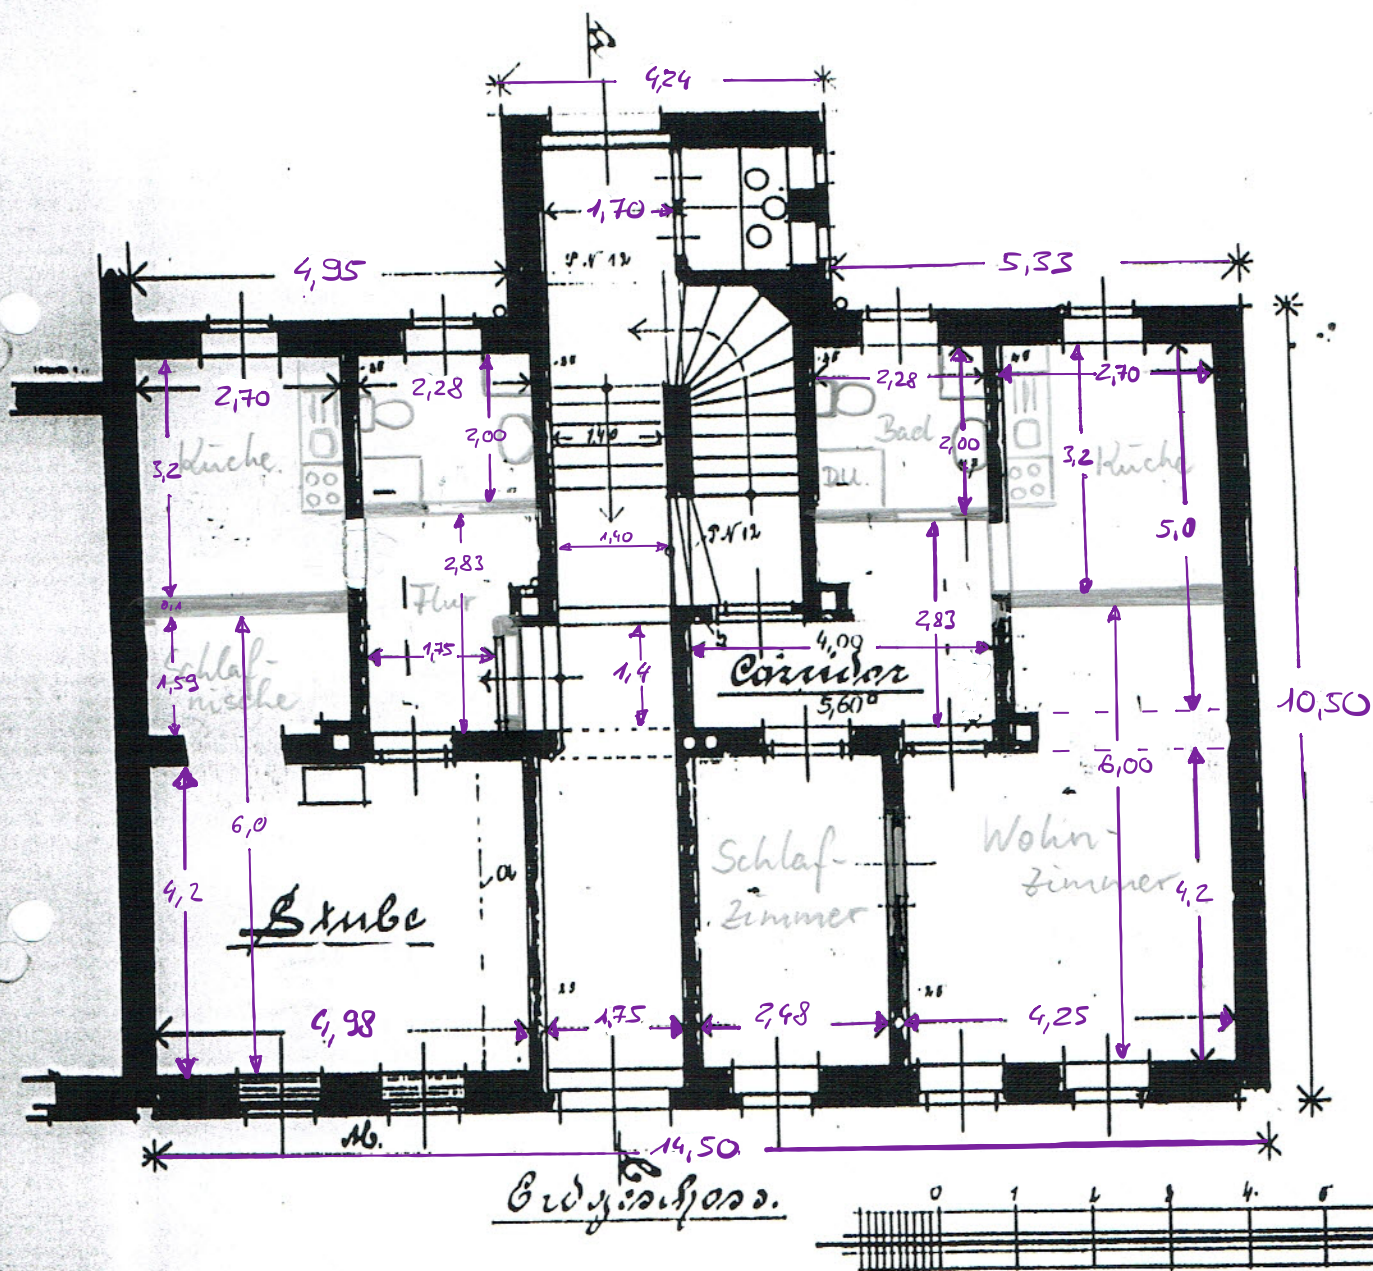

Wo li
Wo re