


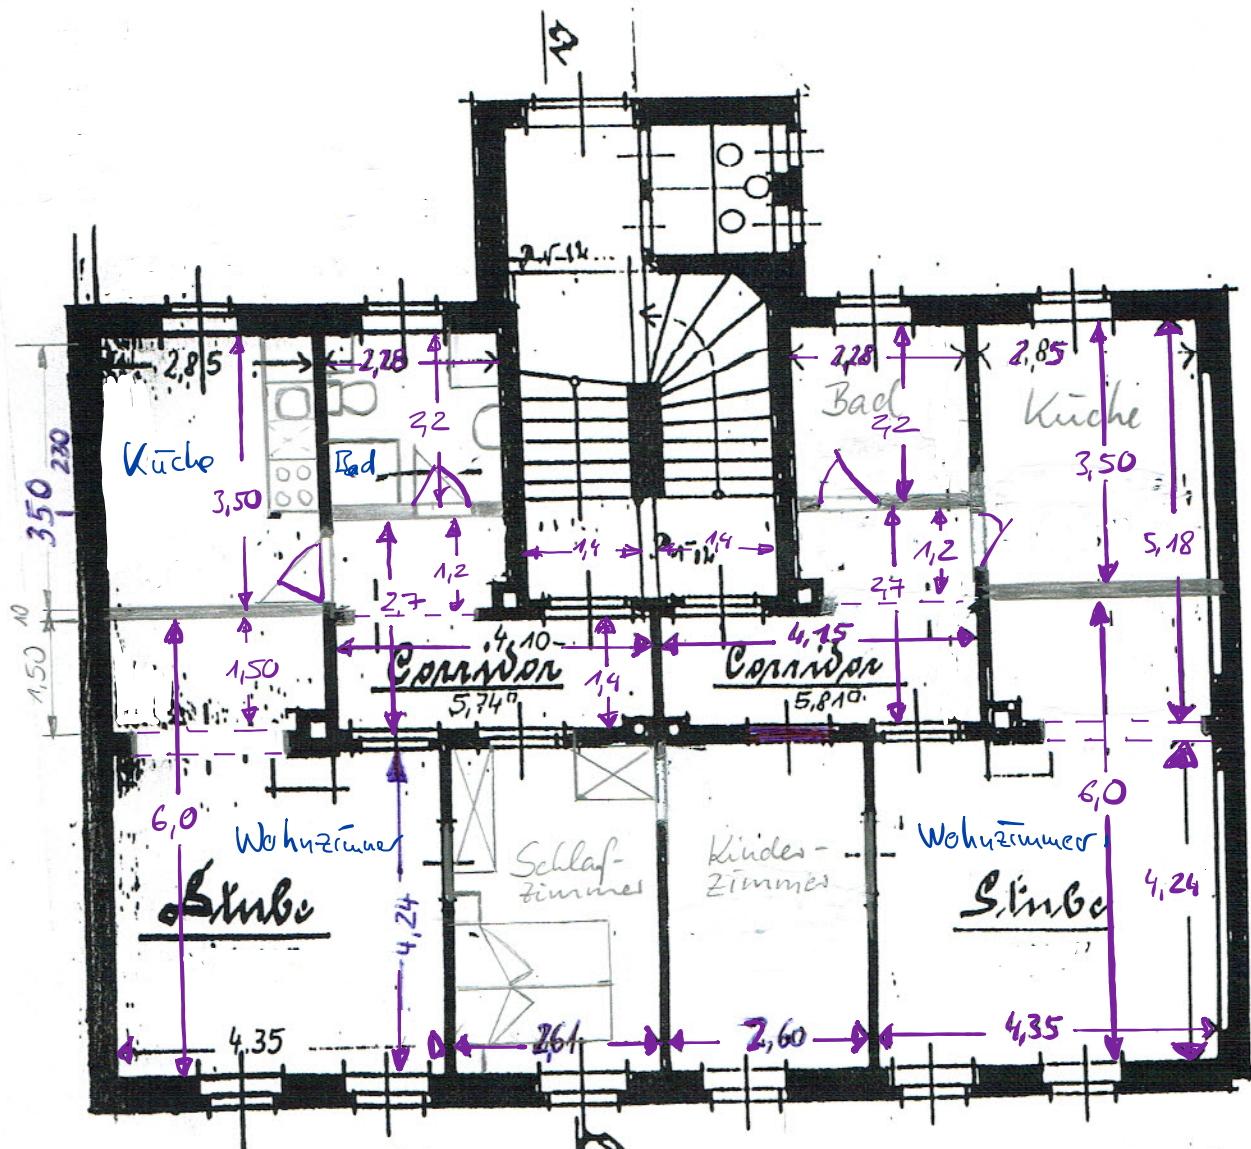

II. Obergeschoss.

Wo li
Wo ne