

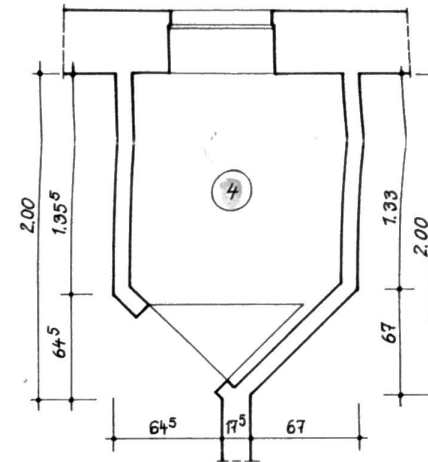


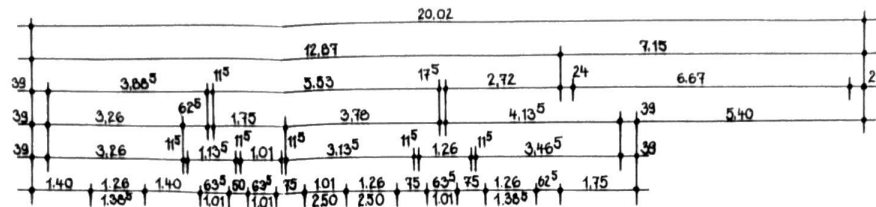

② Position Tür geändert
⑦ Wand geändert

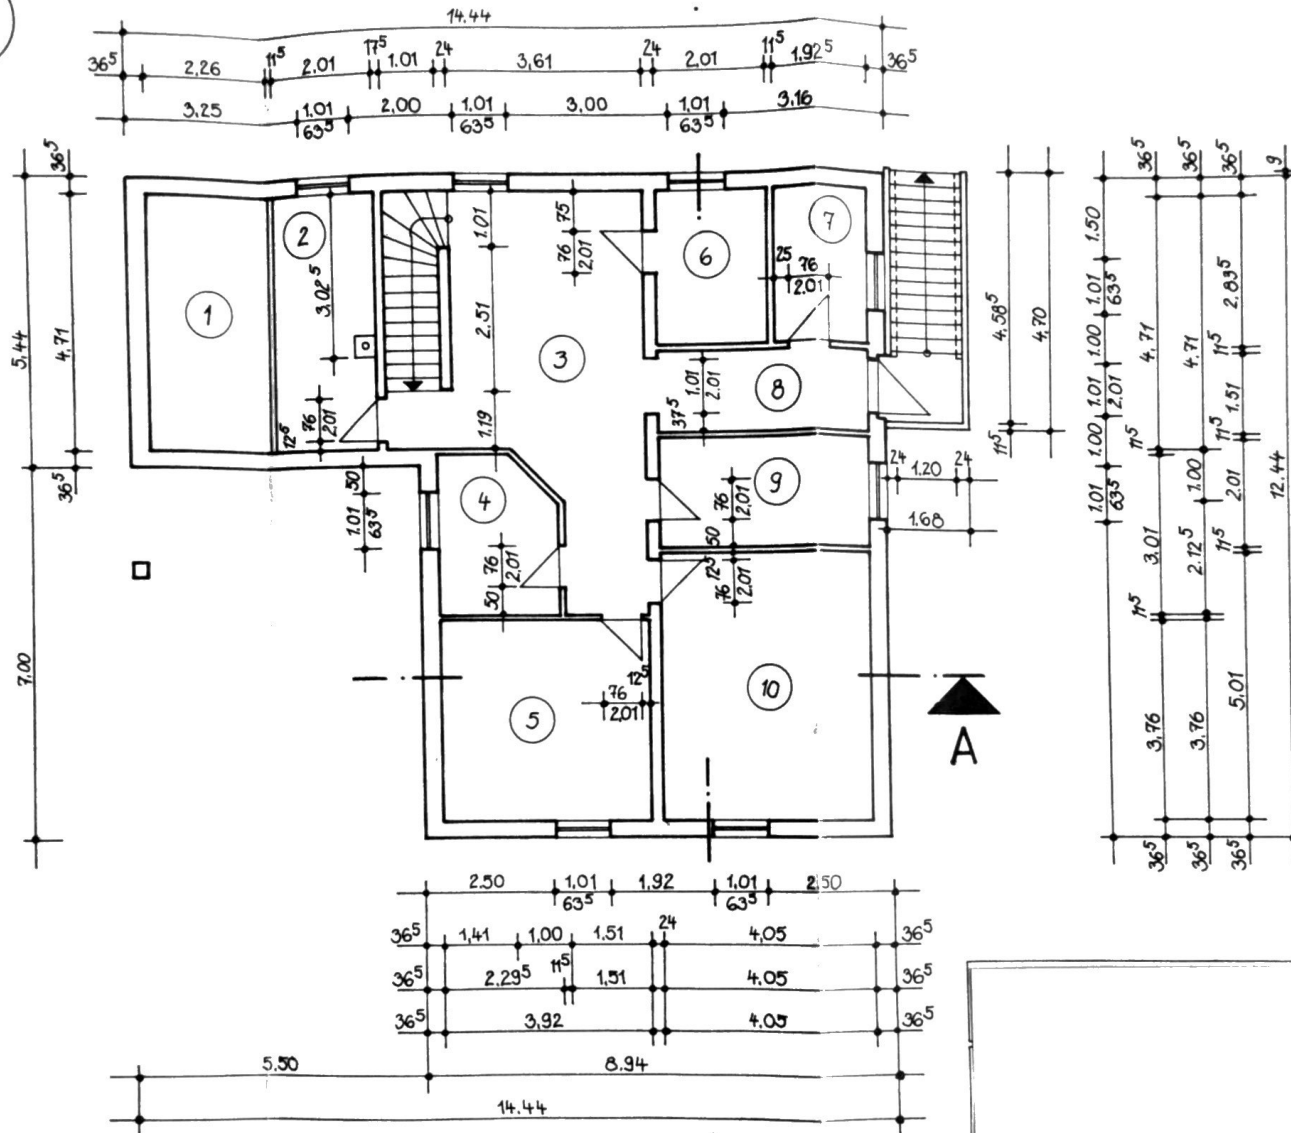

Legende:

- | | |
|-------------|----------|
| 1 Öltank | 10,65 qm |
| 2 Heizung | 9,47 qm |
| 3 Flur | 28,11 qm |
| 4 Keller 1 | 6,50 qm |
| 5 Keller 2 | 14,74 qm |
| 6 Keller 3 | 5,70 qm |
| 7 Keller 4 | 5,46 qm |
| 8 Keller 5 | 6,12 qm |
| 9 Keller 6 | 8,14 qm |
| 10 Keller 7 | 20,29 qm |

$\Sigma = 115,18 \text{ qm}$