


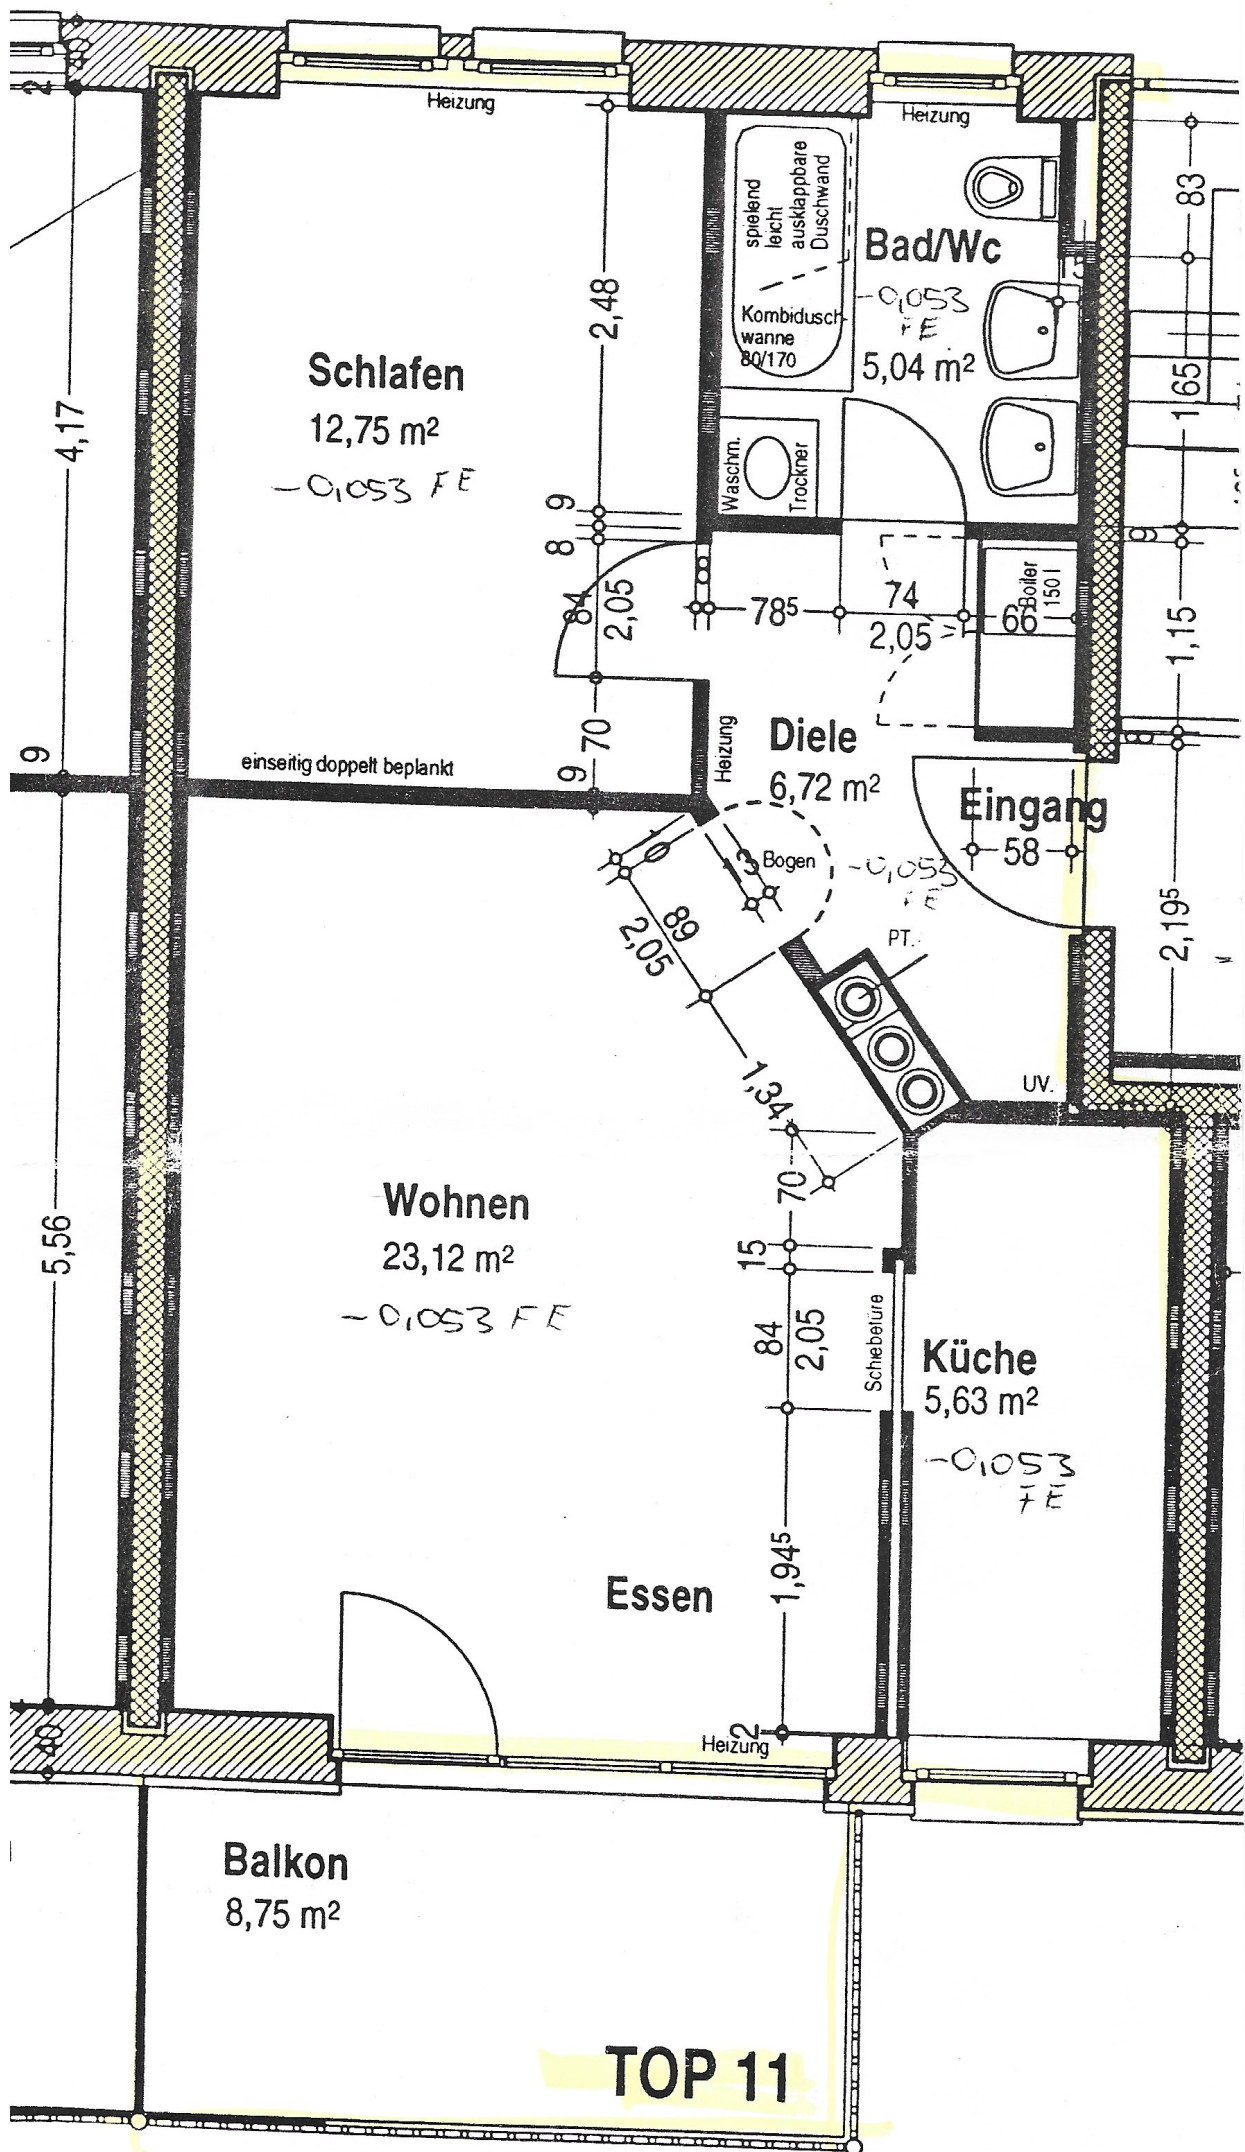

TOP 11